


T.12S.R.4W.W.M.

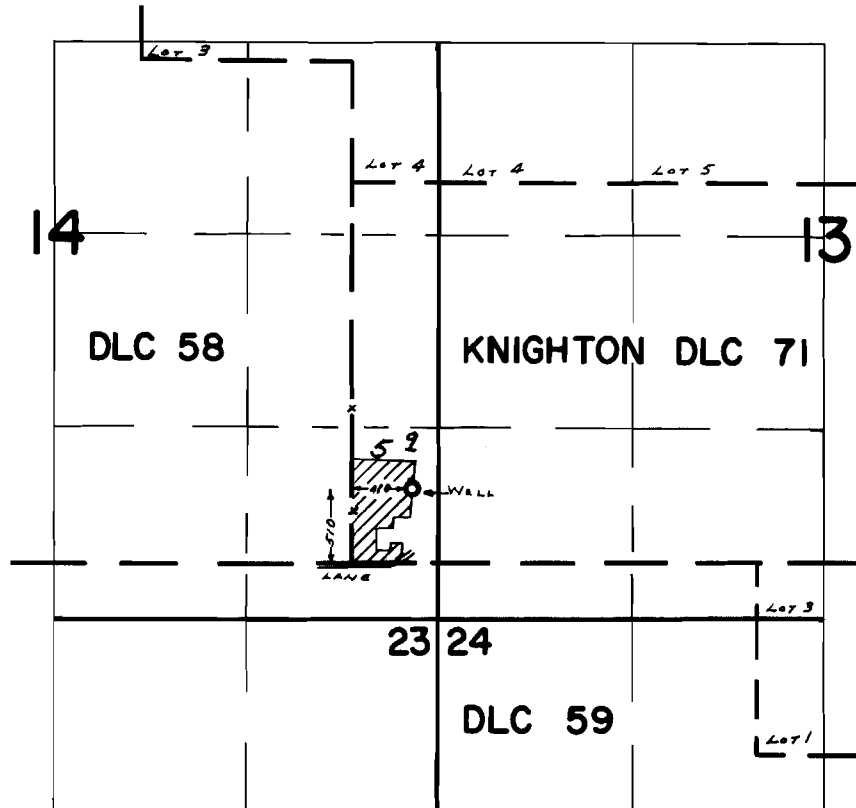

FINAL PROOF SURVEY
UNDER

Application No. G-3046 Permit No. G-2842
IN NAME OF

S. R. & ALICE M. PHILLIPS

Surveyed JUNE 30, 1969, by W. RUPPERT