


T.11S.R.3W.W.M.

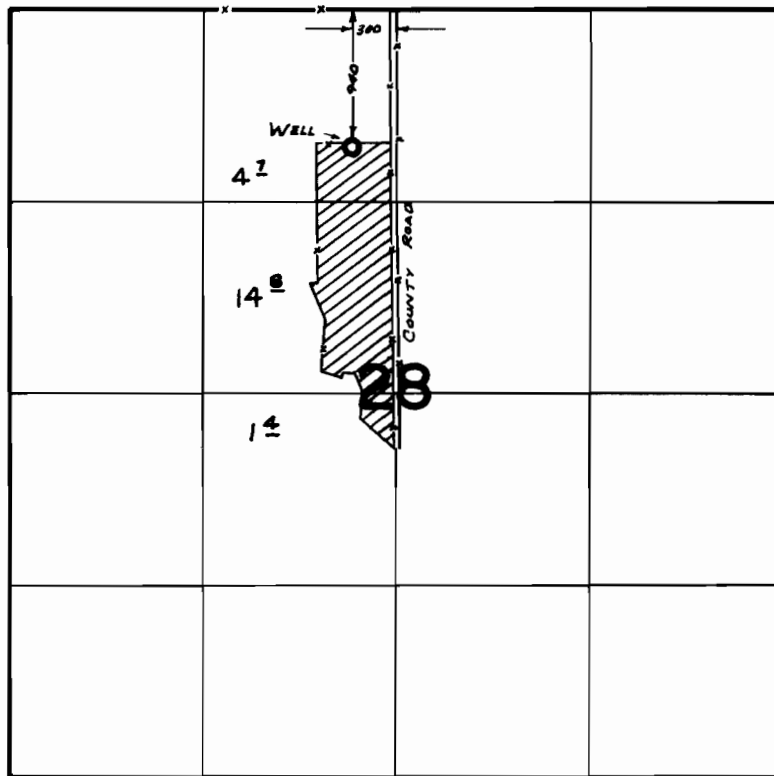

FINAL PROOF SURVEY
UNDER

Application No. G-3144 Permit No. G-2961
IN NAME OF

MERLIN & CAROL FOSTER

Surveyed JUNE 20, 1962, by W. RUPPELT.