


T. 12S. R. 4W. W.M.

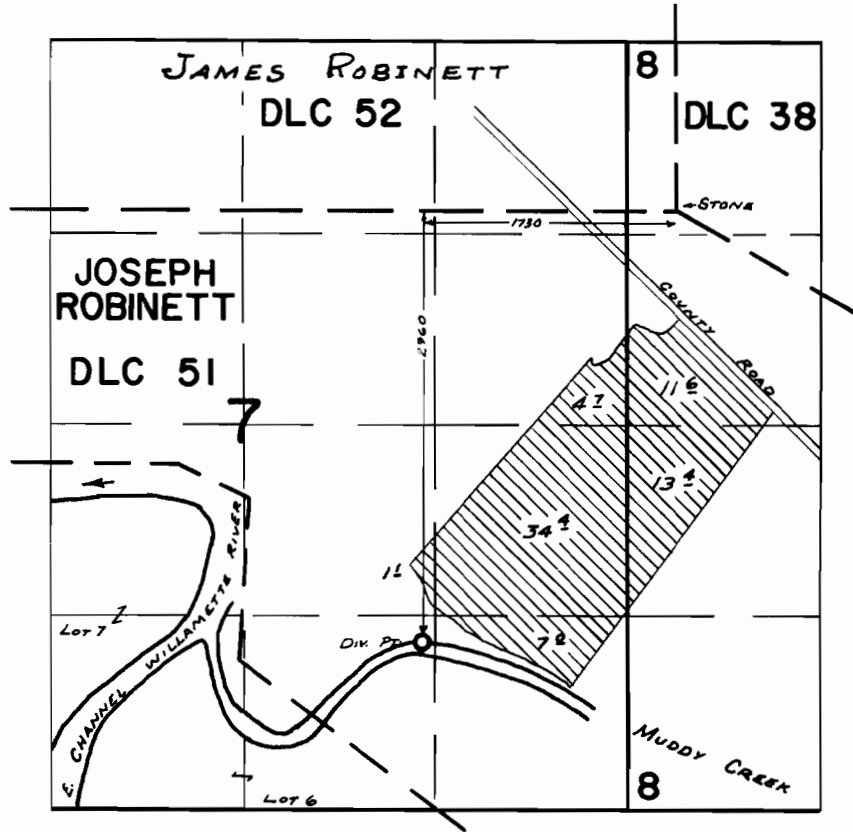

**FINAL PROOF SURVEY**  
UNDER

Application No. 42369 Permit No. 31655  
IN NAME OF

**FLOYD L. & GRACE L. BULMAN**

Surveyed June 30, 1969, by W. RUPPERT