


# T.10S.R.3W.W.M.

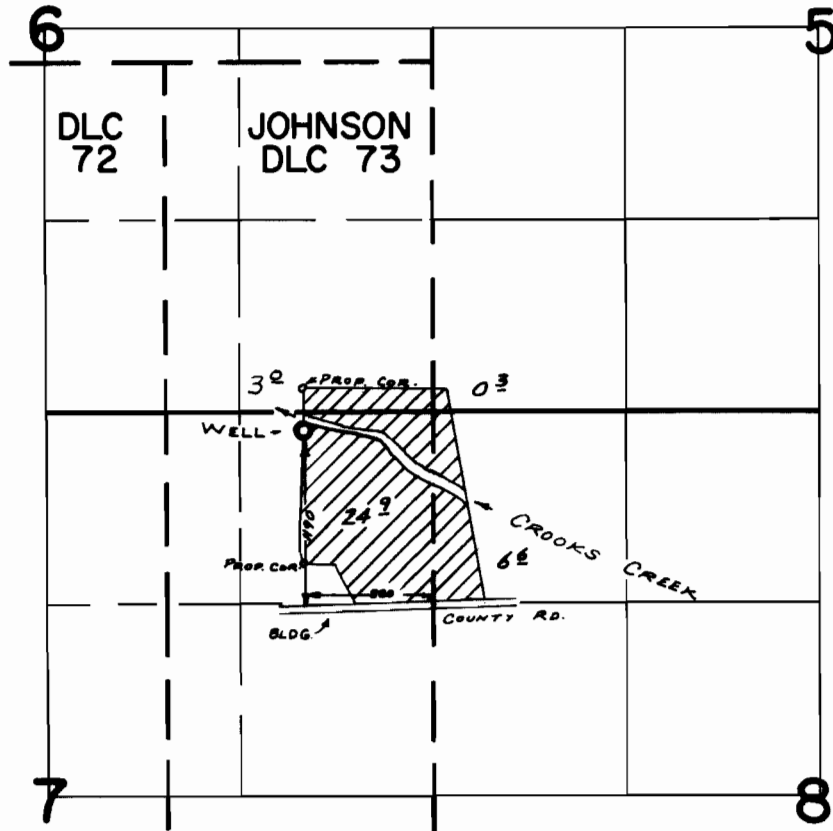

## FINAL PROOF SURVEY UNDER

Application No. G-3712 Permit No. G-3511  
IN NAME OF

**MARVIN W & HELEN E. FLETCHER**

Surveyed MAR. 20, 19.69, by W. RUPPERT