


T.I.S.R.2W.W.M.

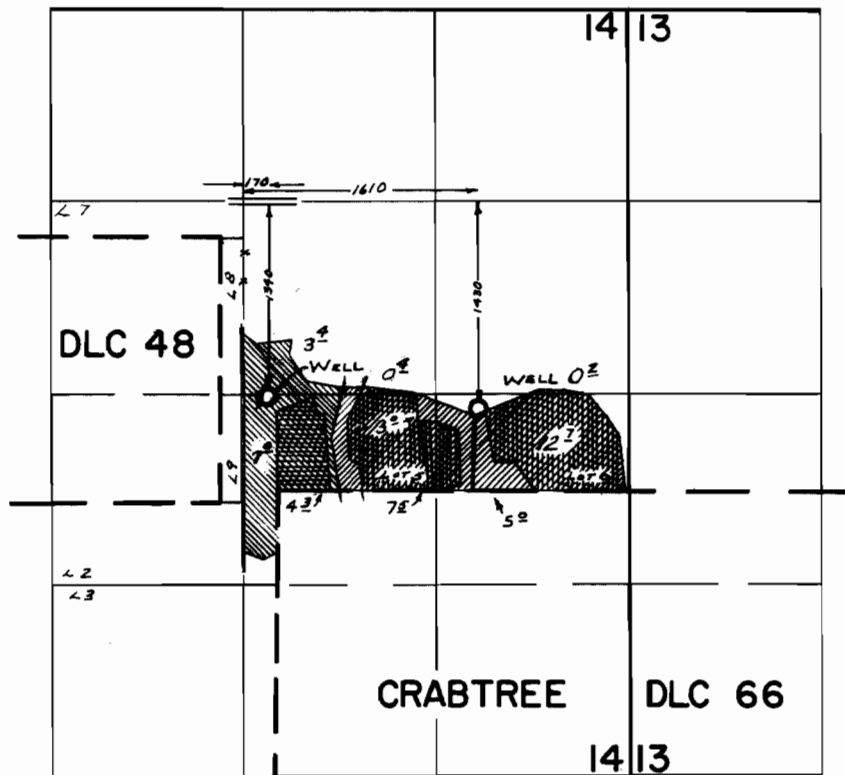

G-3450 PRIMARY
 G-3451 SUPPLEMENTAL

FINAL PROOF SURVEY UNDER

Application No. G-3450 Permit No. G-3256
G-3451 G-3257
 IN NAME OF

CLIFF & LOLA WHISENHUNT

Surveyed May 28, 1969, by W. RUPPERT