


T.10S.R.2W.W.M.

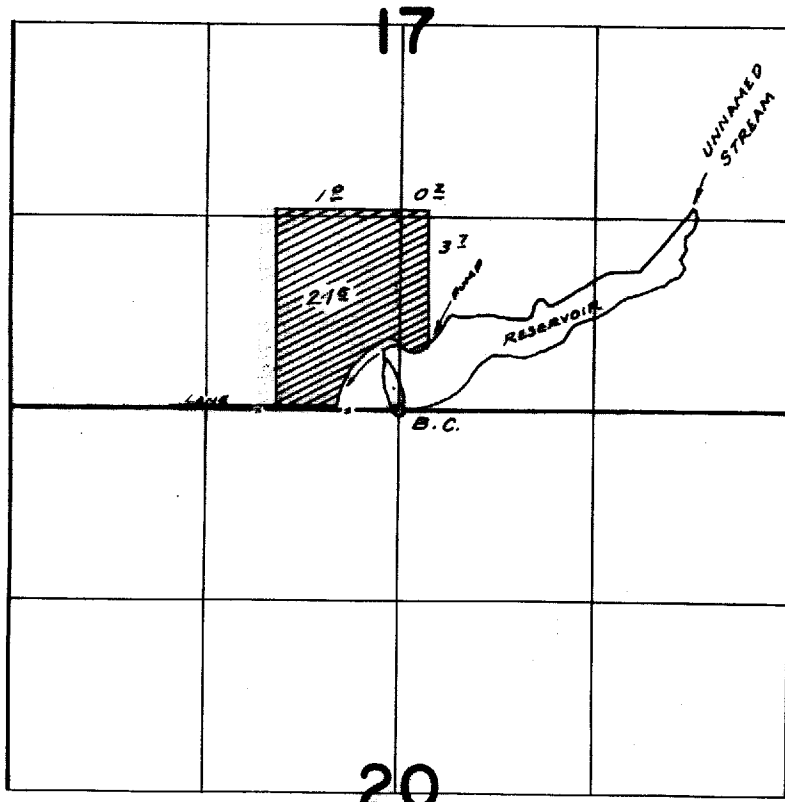

Div. Pt. LOCATED: 140' N. E 30' W. FROM 1/4 Cor. SEC. 17/20

FINAL PROOF SURVEY
UNDER

Application No. R-43380 43381 Permit No. R-4875 32048
IN NAME OF

M. C. & PEARL HELMS

Surveyed MAR. 22, 1969, by W. RUPPERT