T.10 S.R.2 W.W.M.

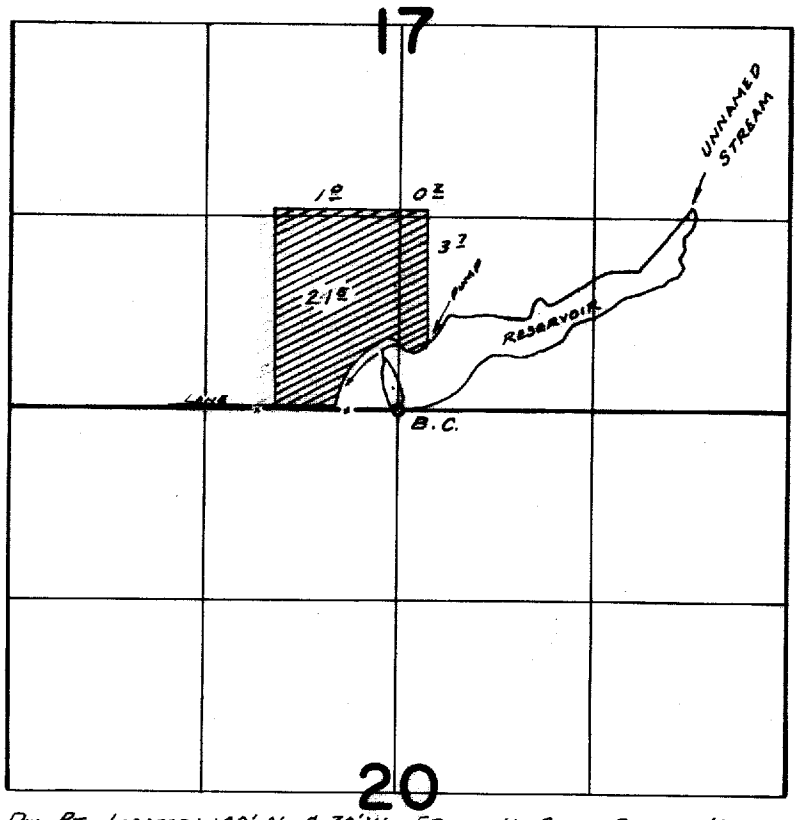

DIV. PT. LOCATED: 140' N. & 30' W. FROM 1/4 COR. SEC. 17/20

FINAL PROOF SURVEY
UNDER

Application No. R-43380 43381 Permit No. R-4875 32048

IN NAME OF

M. C. & PEARL HELMS

Surveyed MAR. 24, 1969, by W. RUPPERT

B.M.
1969-J