


T.9S.R.1W.W.M.

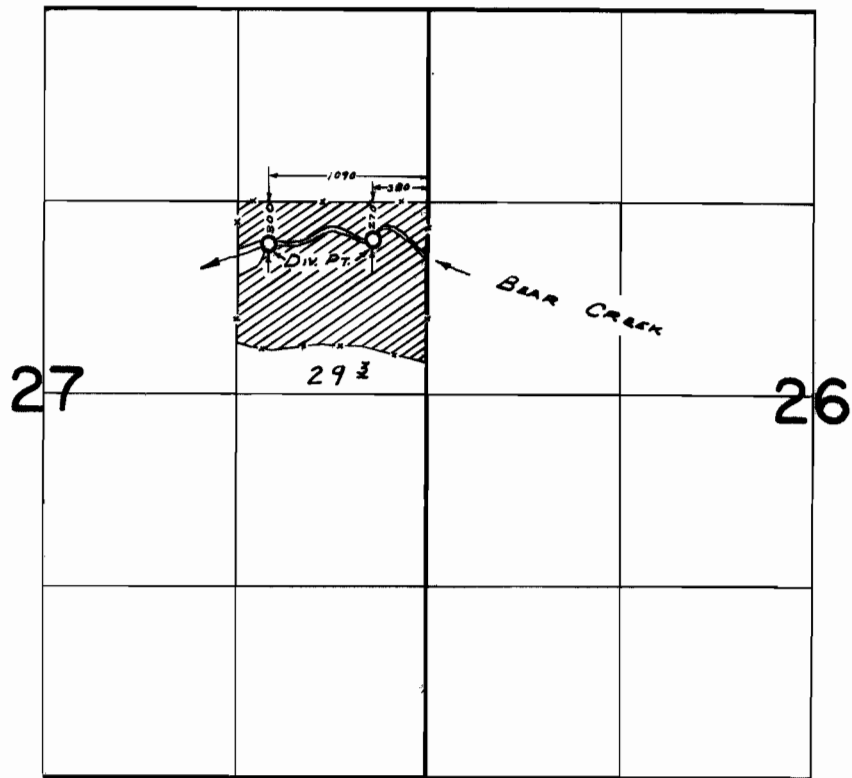

FINAL PROOF SURVEY
UNDER

Application No. 33946 Permit No. 27844
IN NAME OF

ARTHUR SANDNER

Surveyed APR 1, 1969, by W. RUPPERT