


T. 11 S. R. 4 W. W. M.

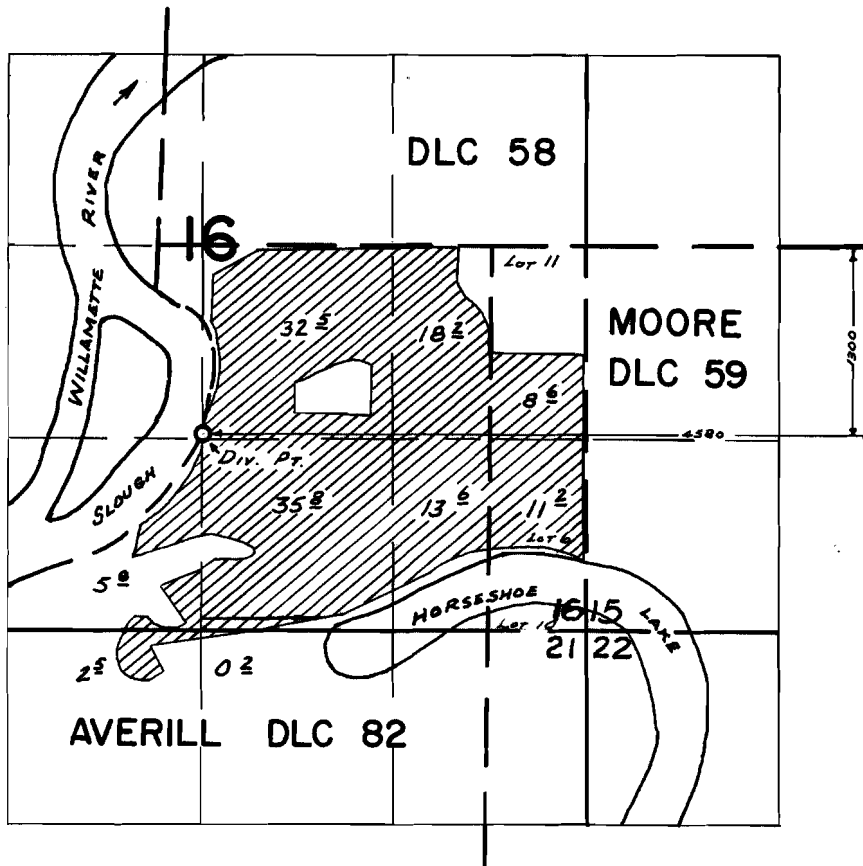

FINAL PROOF SURVEY UNDER

Application No. 40677 Permit No. 30301
IN NAME OF

W. F. & ELDRED C. STELLMACHER

Surveyed July 1, 1969, by W. RUPPERT