


T.10S.R.2W.W.M.

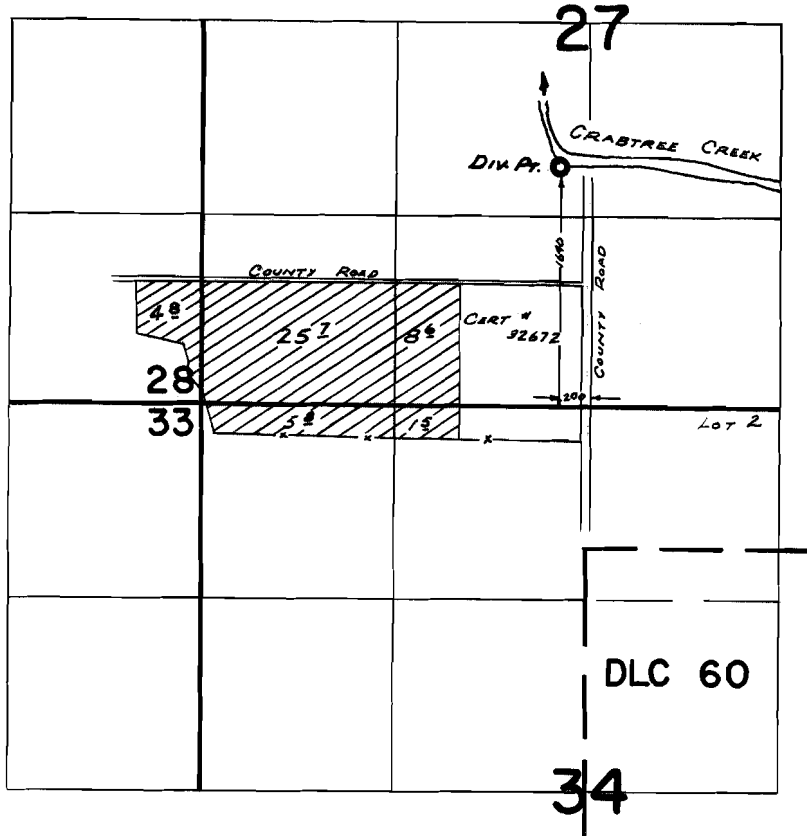

FINAL PROOF SURVEY UNDER

Application No. 43493 Permit No. 32531
IN NAME OF

HARRY C. & SALLIE S. BOSE

Surveyed MARCH 18, 1969, by W. RUPPERT