


T.I.S.R.I.E.W.M.

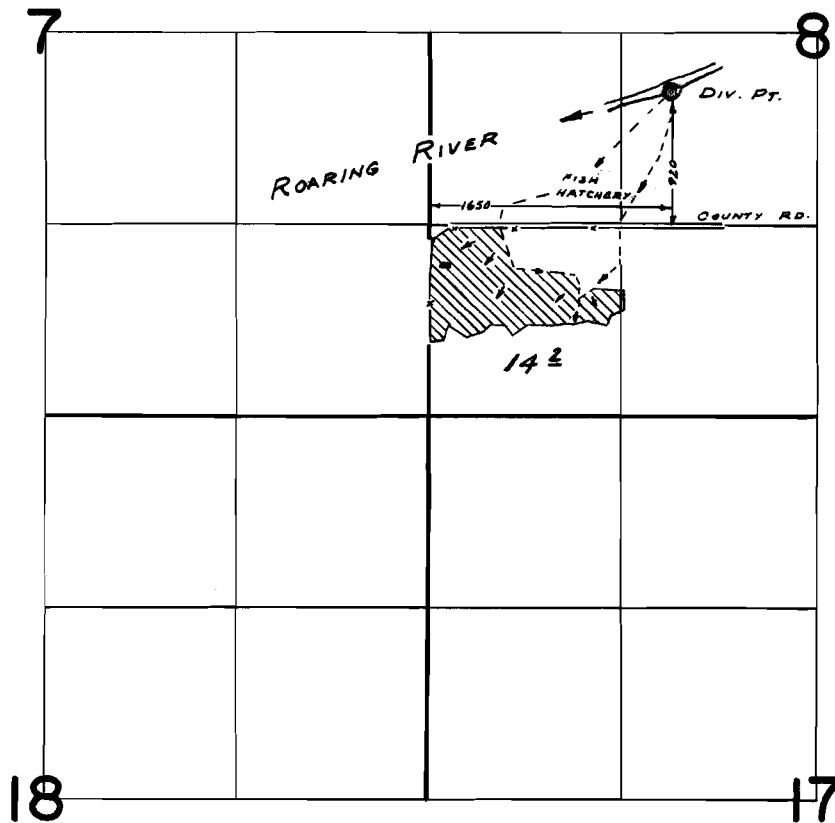

FINAL PROOF SURVEY
UNDER

Application No. 43626 Permit No. 32617
IN NAME OF

CARSON & GERTRUDE DAVENPORT

Surveyed APR. 11, 1969, by W. RUPPERT