


T. 6 S. R. 1 W. W. M.

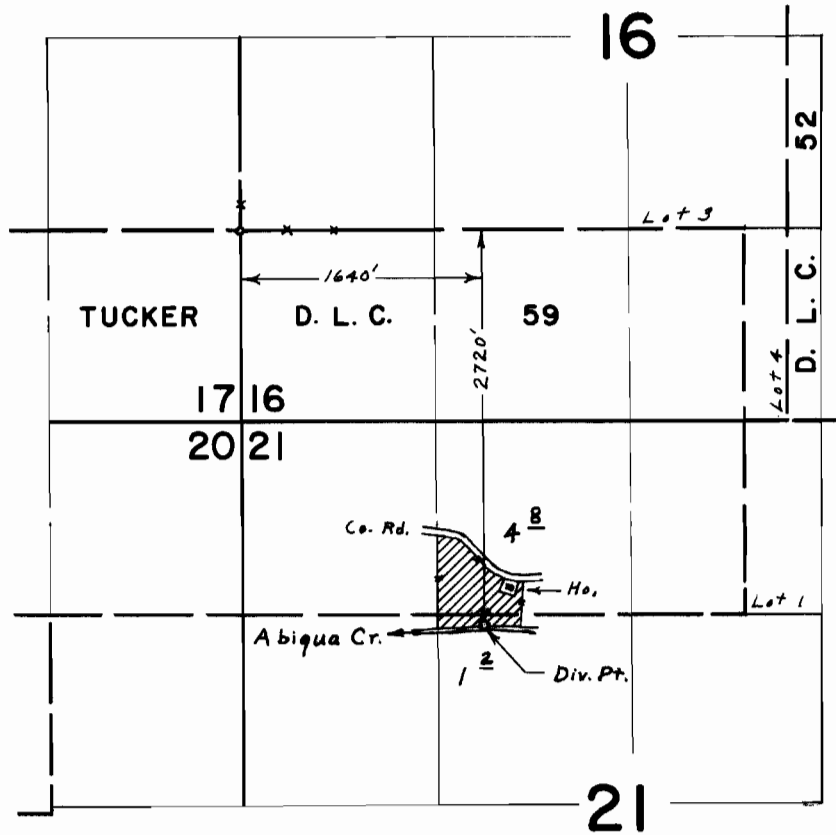

FINAL PROOF SURVEY UNDER

Application No. 38814 Permit No. 28861
 IN NAME OF
 JOSEPH D. & VERONICA M. BALFE &
 JOHN C. & DOROTHY R. HAMMER

Surveyed Nov. 26, 1969, by L. E. Gould