


T. 8 S. R. 5 W. W. M.

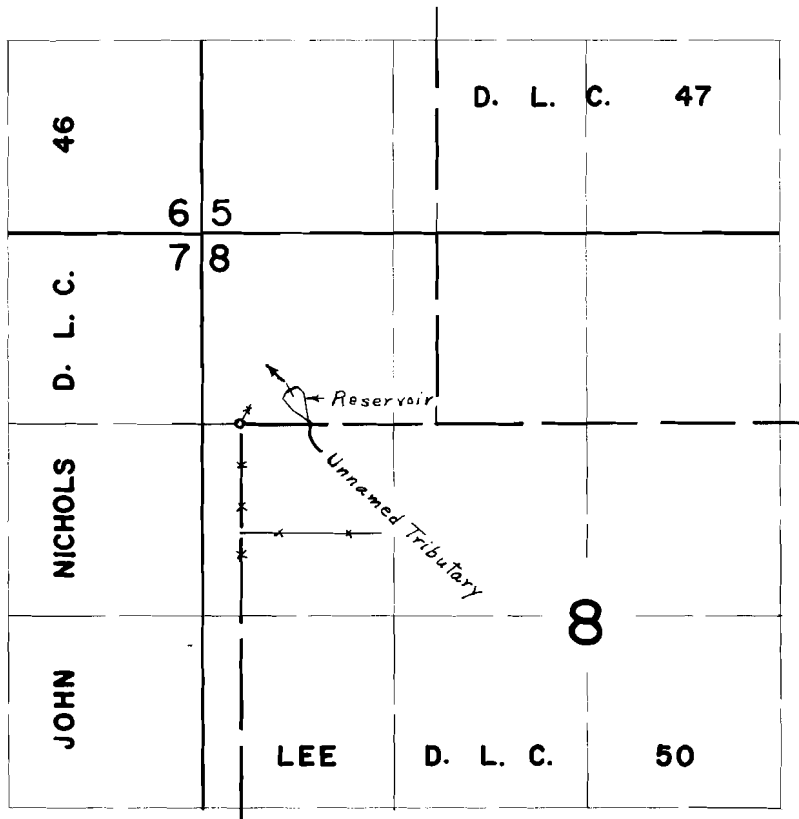

Div. Pt. located 230' N. & 340' E. from N.W. Cor. Lee D.L.C. 50

FINAL PROOF SURVEY UNDER

Application No. R-42193 Permit No. R-4790
IN NAME OF
KENNETH DYER

Surveyed March 17, 1969, by L. E. Gould