


# T.7S.R.5W.W.M.

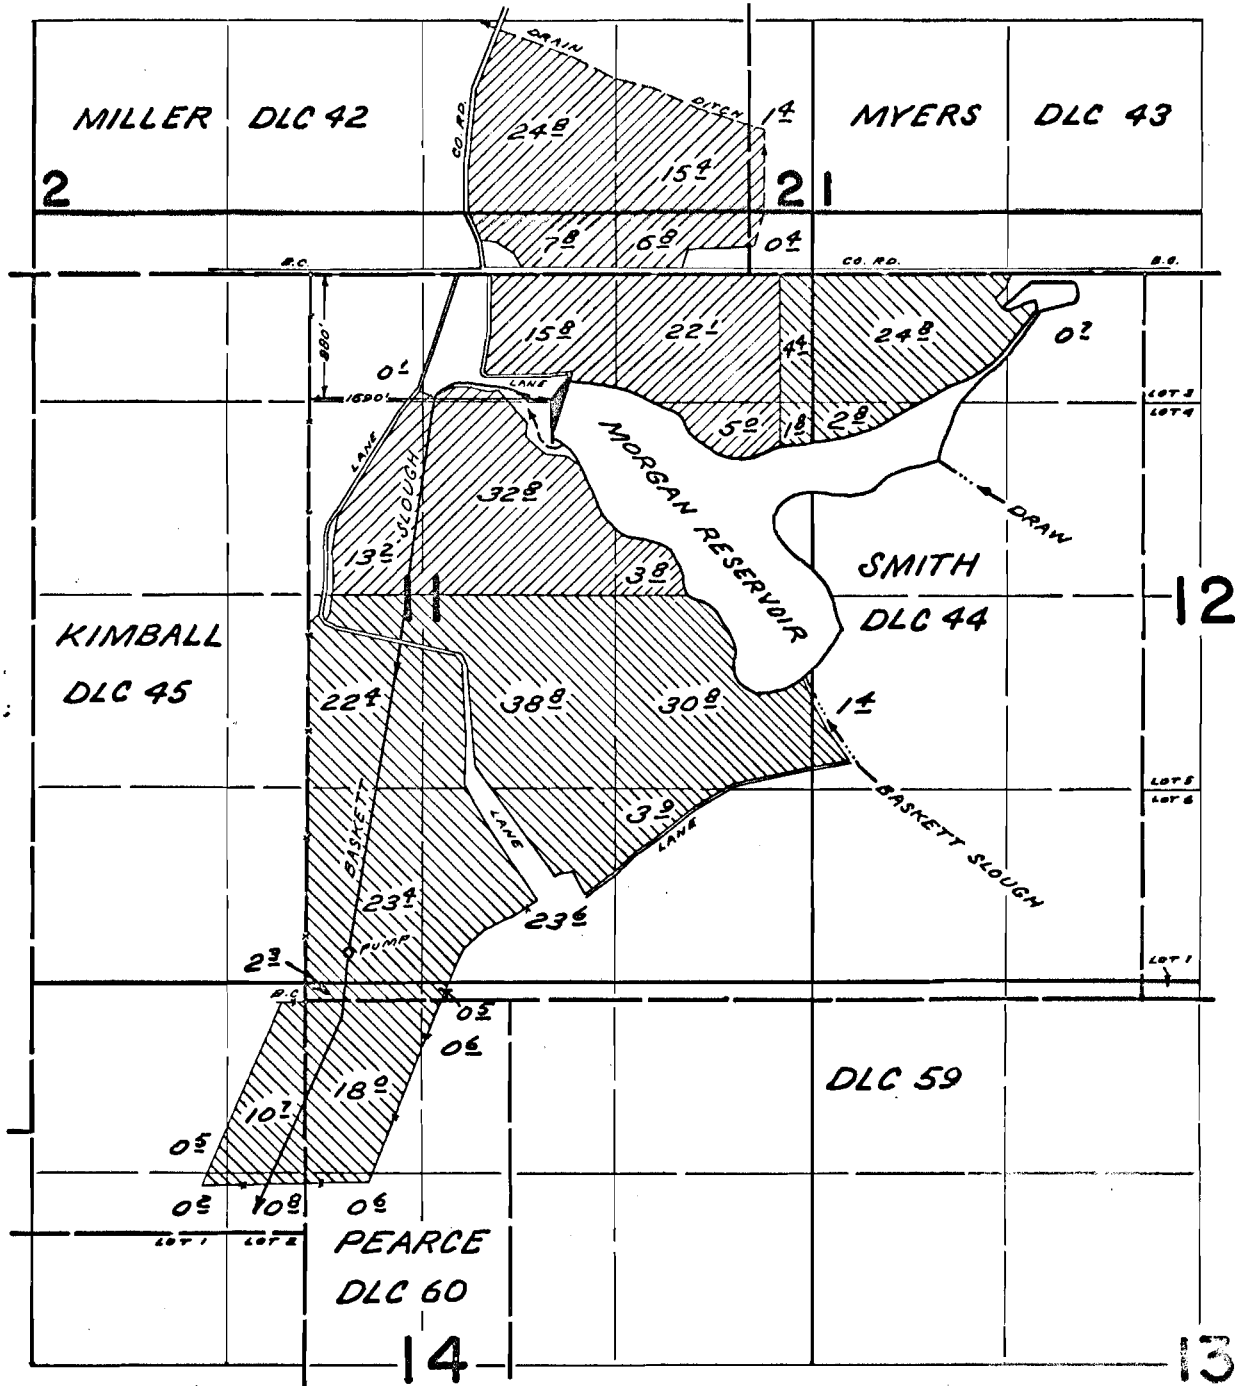

## FINAL PROOF SURVEY

UNDER

R-38035

38036


R-40480

R-3093

28252

R-4520

Application No. 40481 Permit No. 30166

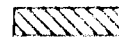

IN NAME OF

UNITED STATES OF AMERICA  
BUREAU OF SPORT FISHERIES AND WILDLIFE

Surveyed Aug. 15 1969, by D. BUELL