


T.7S.R.5W.W.M.

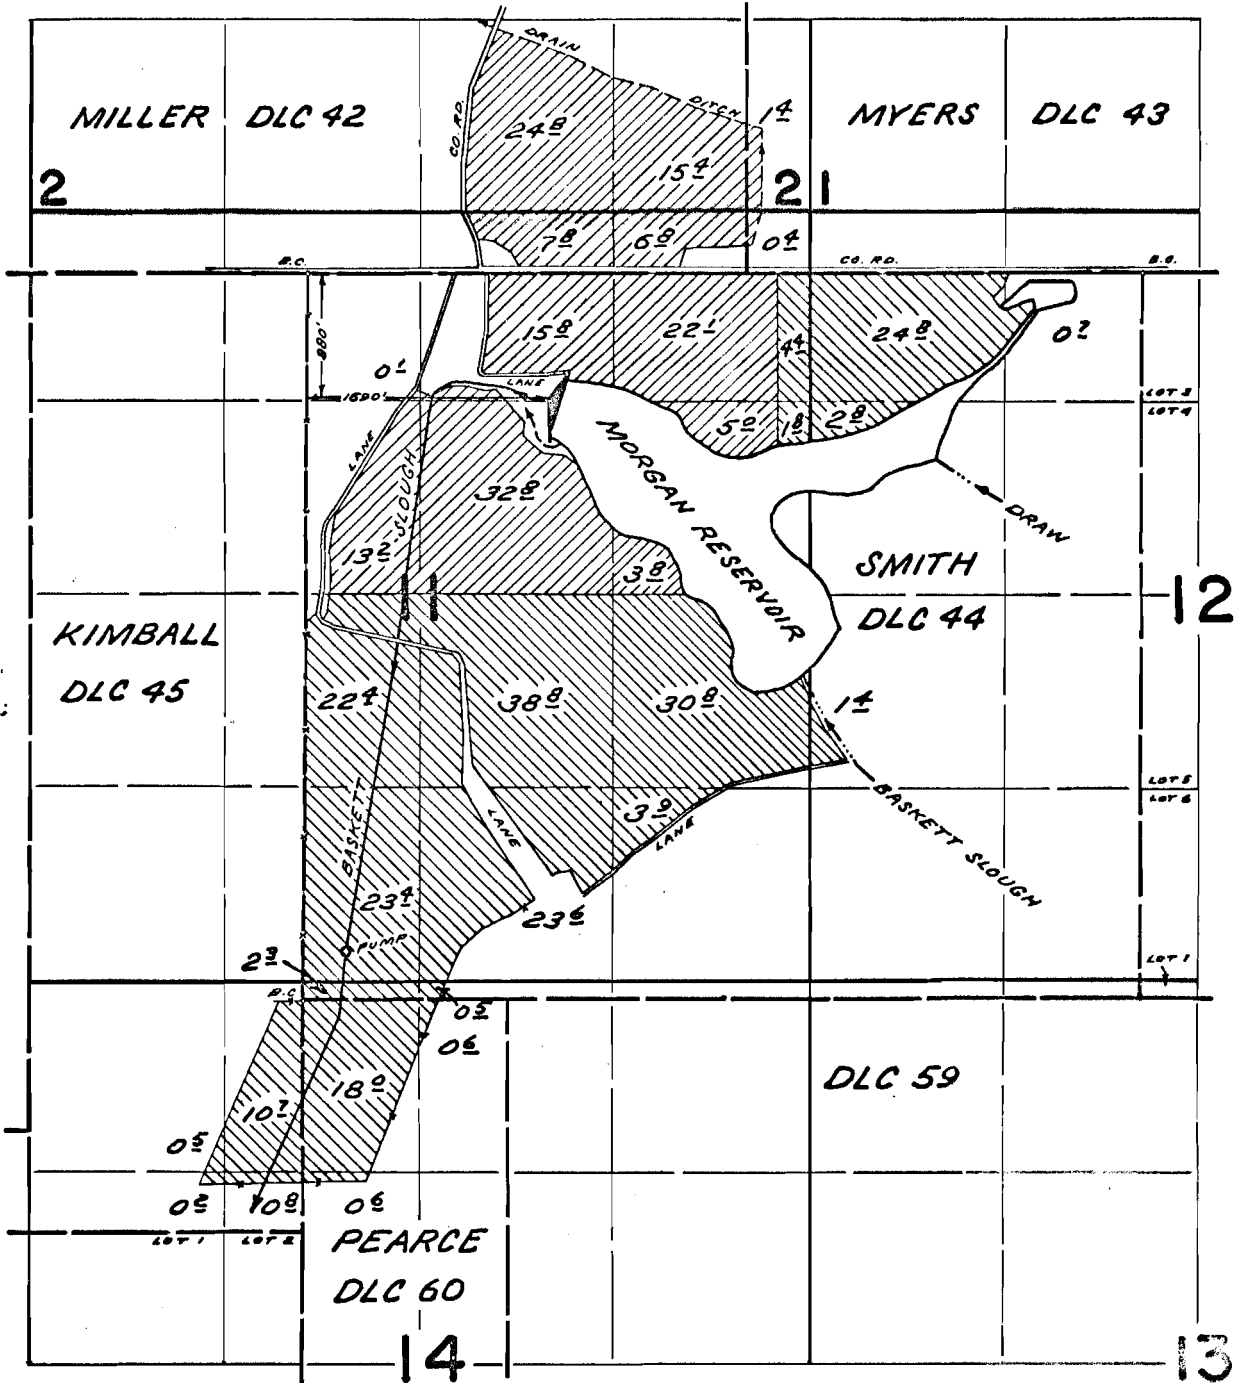

FINAL PROOF SURVEY

UNDER

R-38035

38036

R-40480


40481

R-3093

28252

R-4520

30166

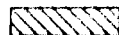

Application No. 40481 Permit No. 30166

IN NAME OF

UNITED STATES OF AMERICA
BUREAU OF SPORT FISHERIES AND WILDLIFE

Surveyed AUG. 15 1969, by D. BUELL