


# T.6&7S.R.5&6W.W.M.

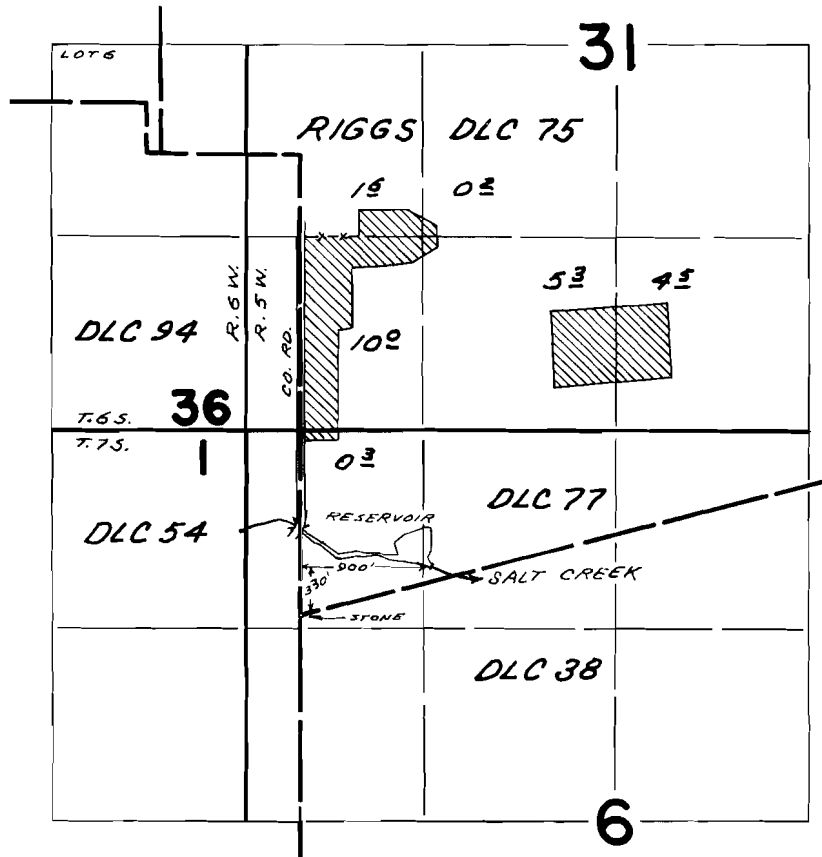

## FINAL PROOF SURVEY UNDER

Application No. R-41372 41373 Permit No. R-4667 30905  
IN NAME OF

SILAS E. STARR

Surveyed APR 23 1969, by D. BUELL  
MAR 20, 1961 M. BISH