


# T. 8 S. R. 4 W. W. M.

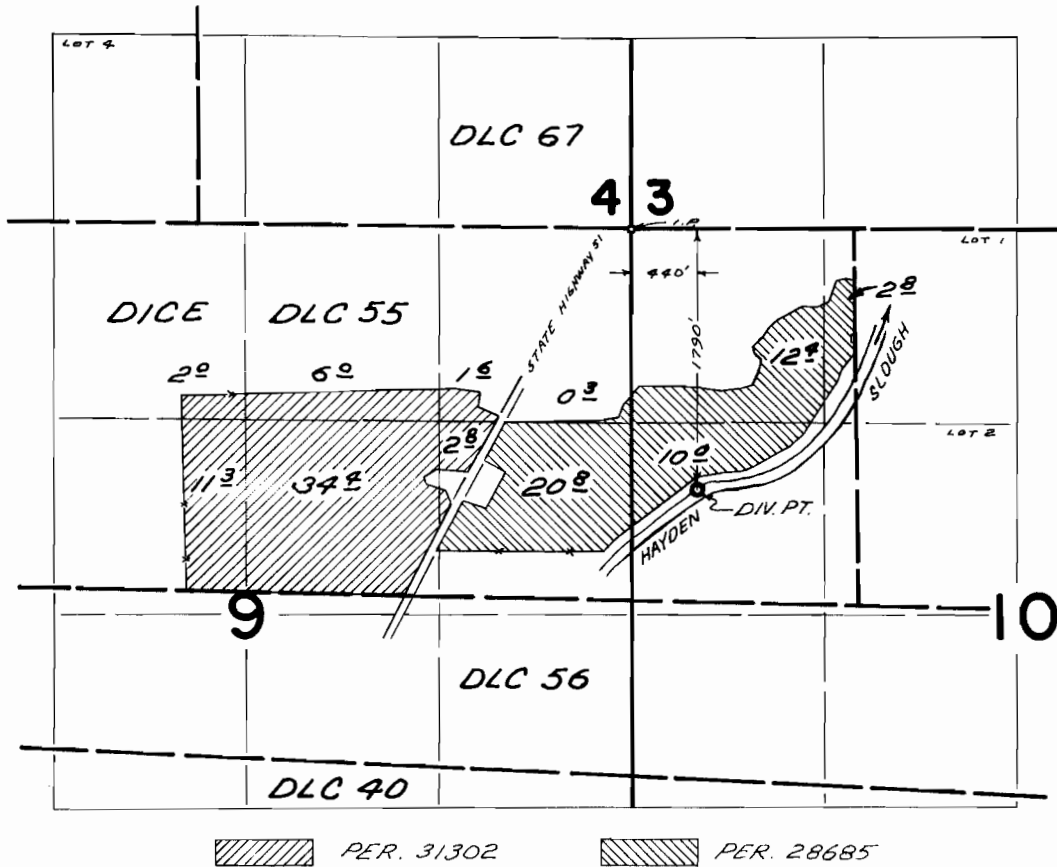

## FINAL PROOF SURVEY UNDER

Application No. 38555 Permit No. 28685  
41820 IN NAME OF

EDWARD GIESBRECHT

Surveyed MAY 16 1969, by D. BUELL