


T. 8 S. R. 4 W. W. M.

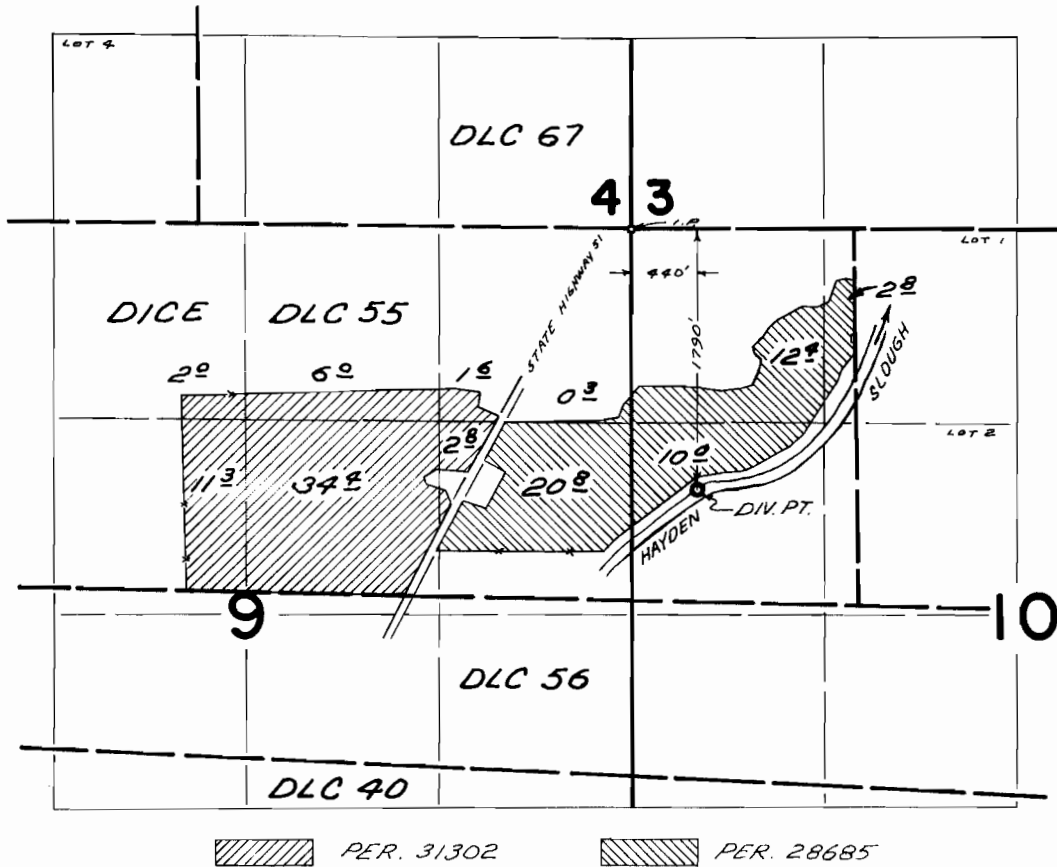

FINAL PROOF SURVEY UNDER

Application No. 38555 Permit No. 28685
41820 Permit No. 31302
 IN NAME OF

EDWARD GIESBRECHT

Surveyed MAY 16 1969, by D. BUELL