
T. 7 S.R. 4 W. W.M.

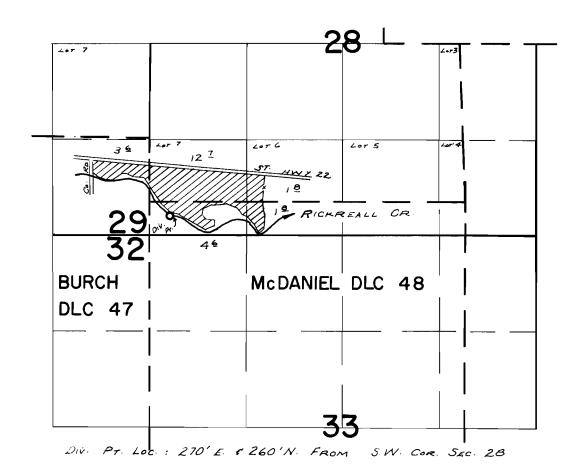

FINAL PROOF SURVEY

Application No. 4495/ Permit No. 33599 IN NAME OF

EDWARD W. GIESBRECHT

Surveyed SEPT 3 1969, by D. BUELL