



C3747

1
1
0
7

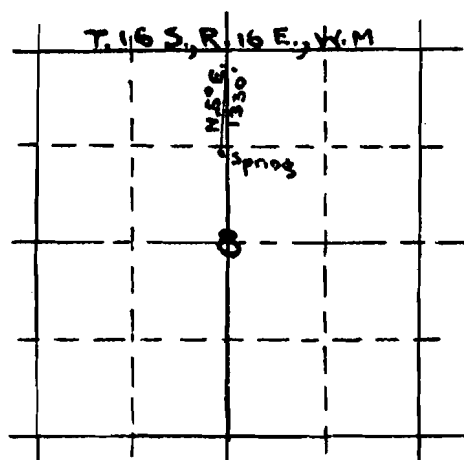

Map
of
Section 8, T.16 S., R.16 E.
Showing
Dry Creek Spring
Scale 2" = 1 mile

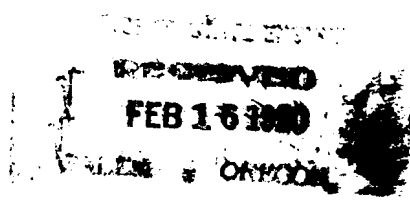

Application No. 7077
Permit No. 4438

4438