


T.8S.R.5&6W.W.M.

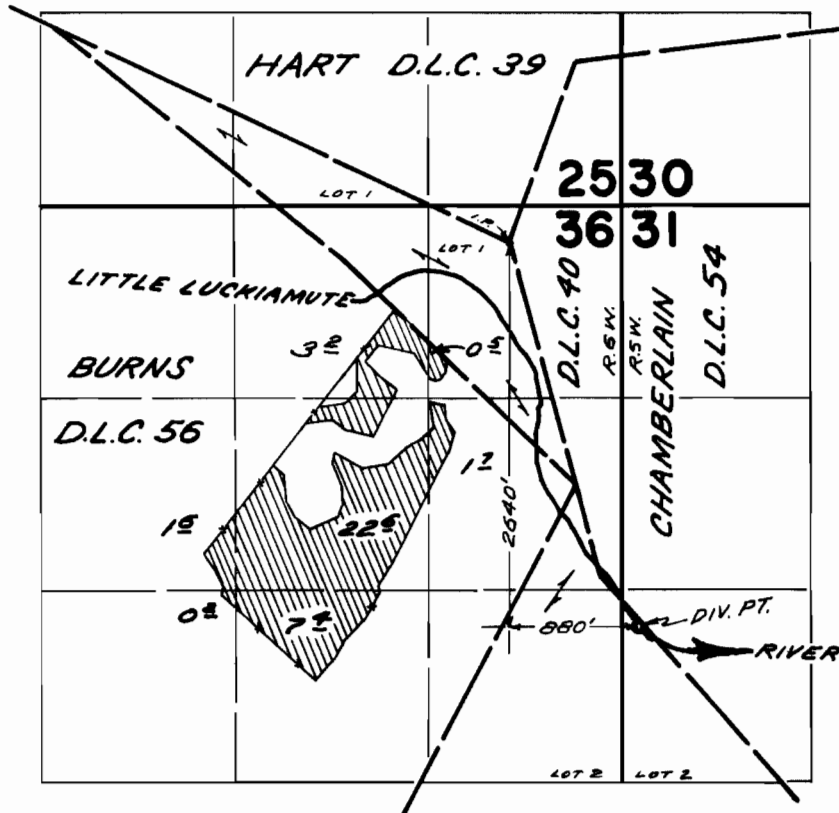

FINAL PROOF SURVEY UNDER

Application No. 38923 Permit No. 28913
IN NAME OF

C. J. MOSER

Surveyed MAR. 26 1969, by D. BUELL