


T.7S.R.4&5W.W.M.

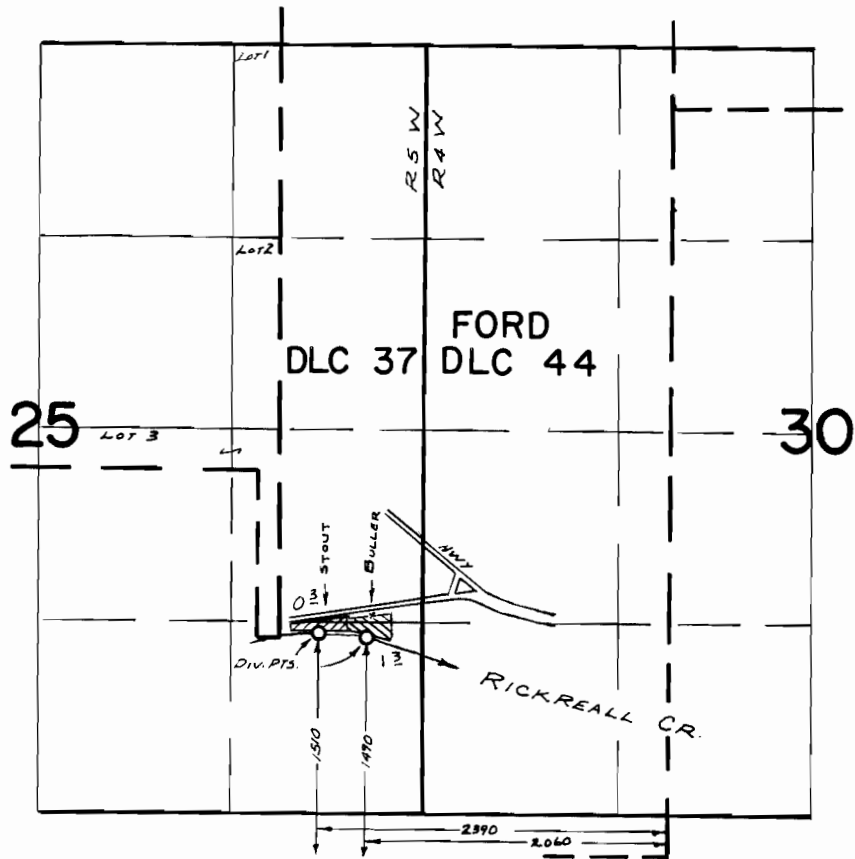

FINAL PROOF SURVEY
UNDER

Application No. 39431 Permit No. 29513

IN NAME OF
W. T. & SARAH STOUT
JOHNNIE GERALD, JOHN H. & NETTIE BULLER

Surveyed SEPT. 5, 1969, by D. BUELL