


T.7S.R.48&5W.W.M.

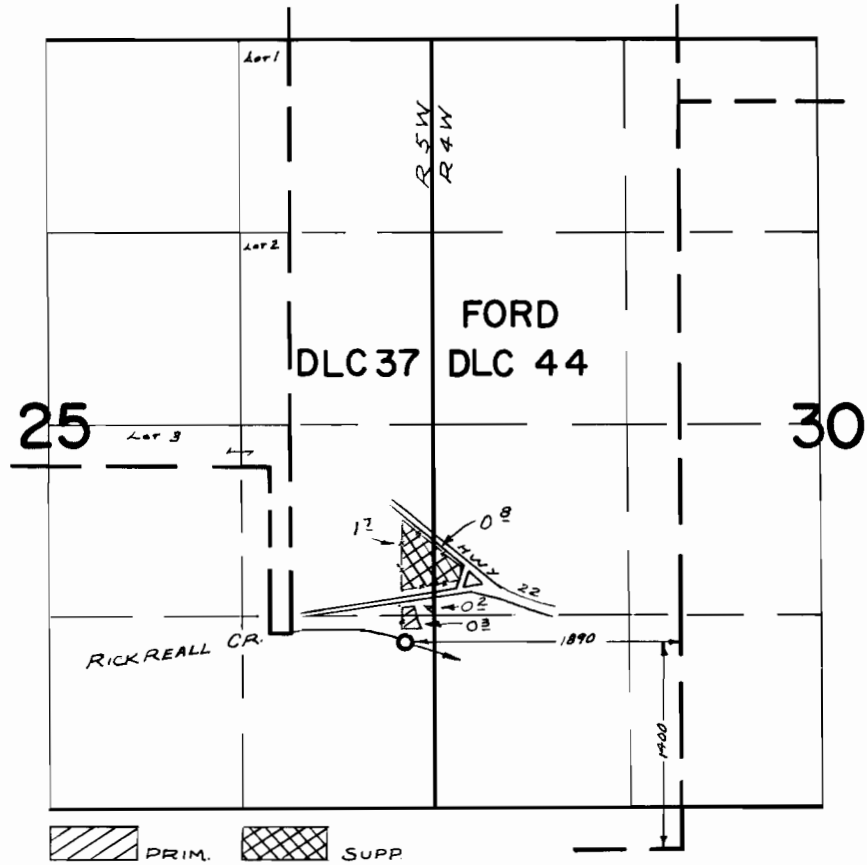

FINAL PROOF SURVEY UNDER

Application No. 43169 Permit No. 32270
IN NAME OF

MERRITT E. HART

Surveyed SEPT. 5, 1969, by D. BUELL