30646

T. 1 S. R. 13 E. W. M.

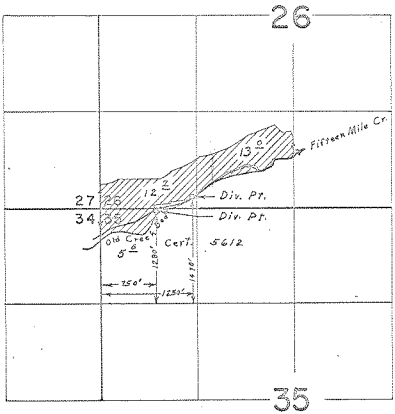

FINAL PROOF SURVEY
UNDER

Application No. 41083 Permit No. 30646
IN NAME OF

HARRY E. CARLETON

Surveyed Nov. 6, 1969, by L. E. Gould

1969-X