


T. 2 N. R. 3 W. W.M.

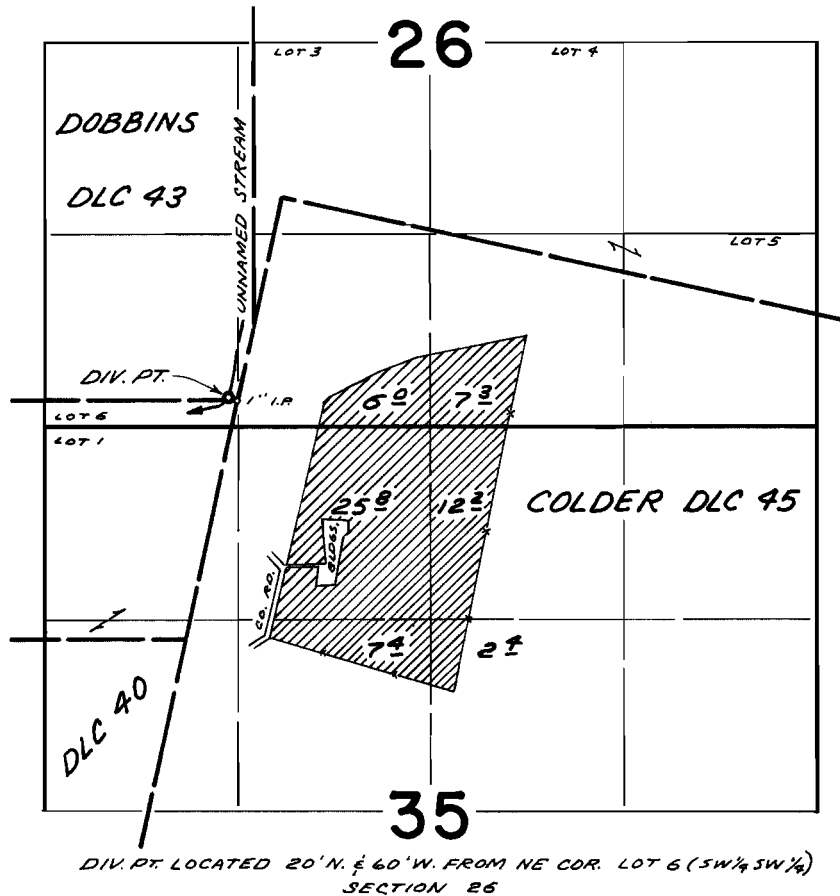

FINAL PROOF SURVEY UNDER

Application No. 40675 Permit No. 30299
IN NAME OF

JOE BAKER

Surveyed MAY 6 1969, by D. BUELL