


T. 3S. R. 4W. W.M.

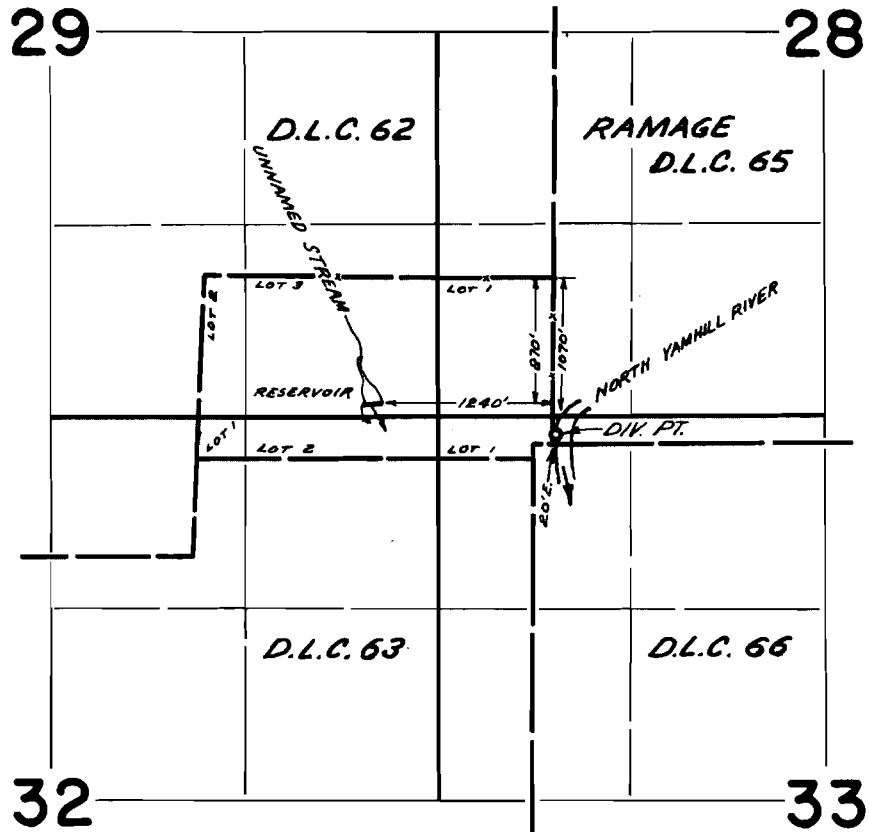

FINAL PROOF SURVEY UNDER

Application No. R-40272 40273 Permit No. R-4480 29958

IN NAME OF

JOHN SITTON

Surveyed MAY 2 1969, by D. BUELL