


T.8S.R.46E.W.M.

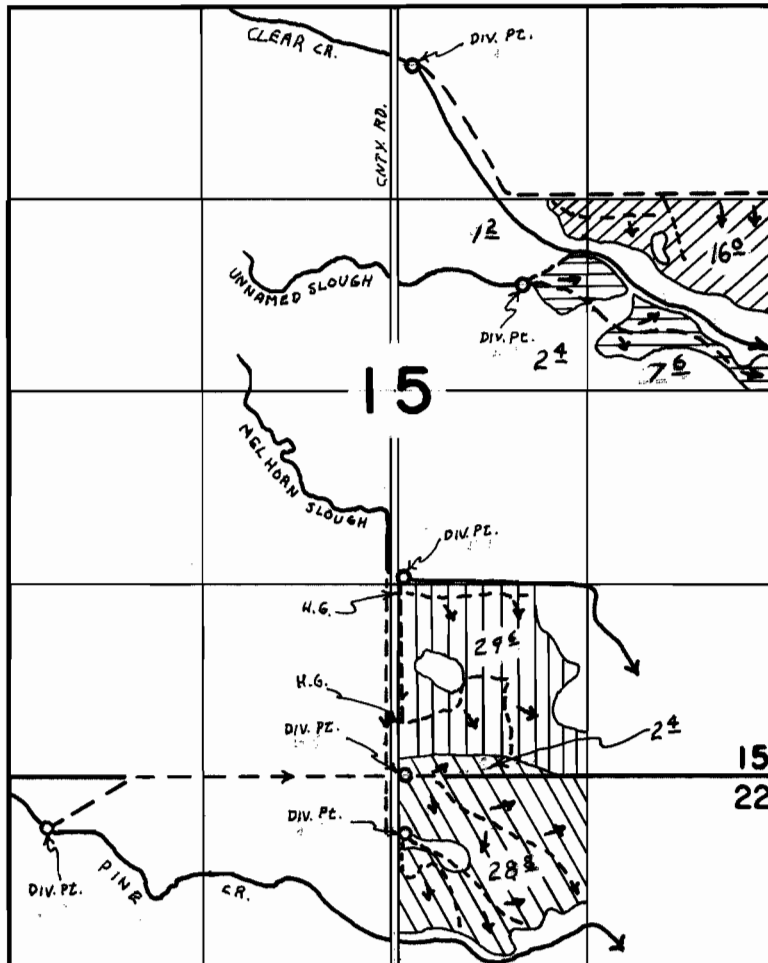

DIV. PTS. LOC.: CLEAR CR. 2250'N. & 130'E.; UNN. SLOUGH 730'N & 890'E.; MELHORN SLOUGH 1270'S. & 70'E.; WASTEWATER 2650S. & 70'E., 3050'S. & 70'E.; PINE CR. 3000'S. & 2370'W.; ALL FROM CENTER SEC. 15

FINAL PROOF SURVEY UNDER

Application No. 32941 Permit No. 26034
IN NAME OF

J. V. THOMAS

NOV. 18, 1964 by R. JACKSON
Surveyed JULY 15, 1970, by D. BUELL