


T.9S.R.39E.W.M.

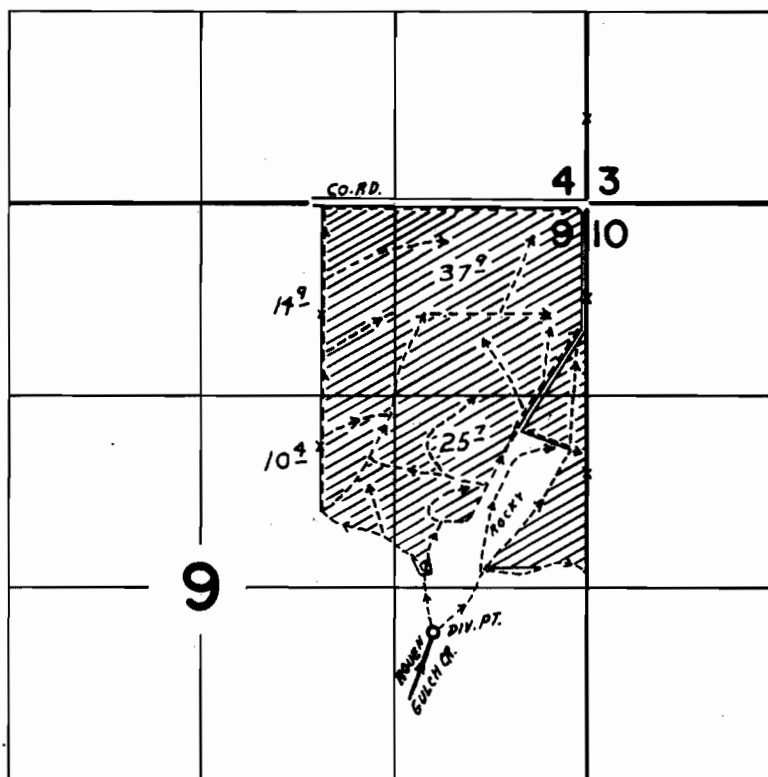

DIV. PT. LOC. 2950'S. & 1050'W. FROM NE COR. SEC. 9

FINAL PROOF SURVEY
UNDER

Application No. 45133 Permit No. 33722
IN NAME OF

MAUD A. SCHROEDER

Surveyed JULY 22, 1970, by L. E. GOULD