


T. 14 S. R. 5 W. W. M.

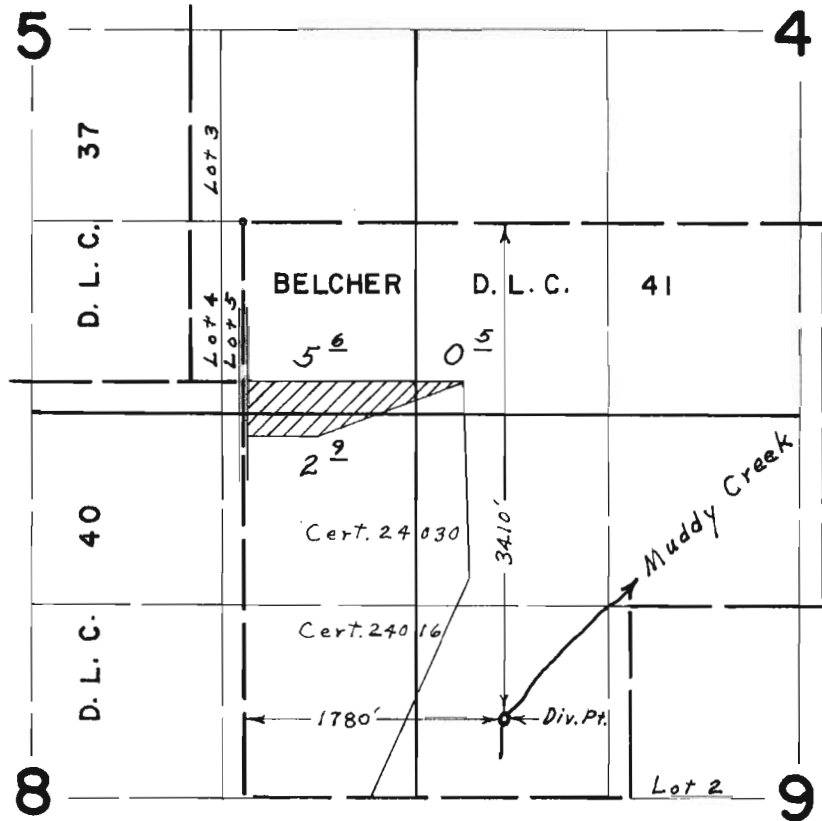

FINAL PROOF SURVEY

UNDER

Application No. 42410 Permit No. 31671

IN NAME OF

CHESTER B. READER

Surveyed May 28, 1970, by L. E. Gould