


T. 14 S. R. 8 W. W. M.

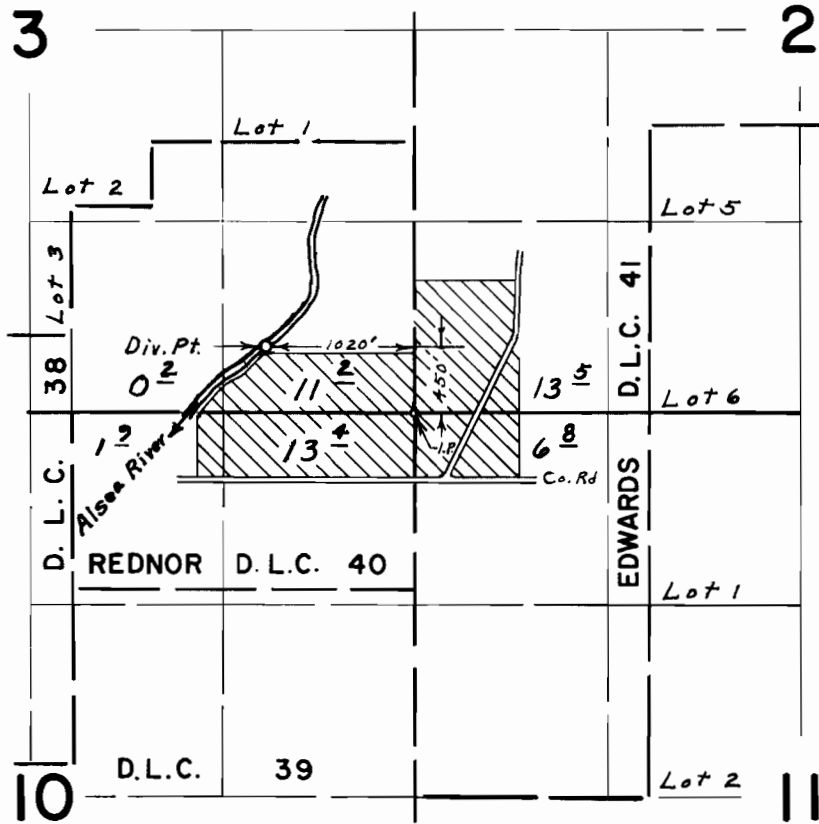

FINAL PROOF SURVEY UNDER

Application No. 38543 Permit No. 28677
IN NAME OF

LOUIS A. MOHNIKE

Surveyed Sept. 10, 1970, by L. E. Gould