T. 1 & 2 S. R. 1 E. W. M.

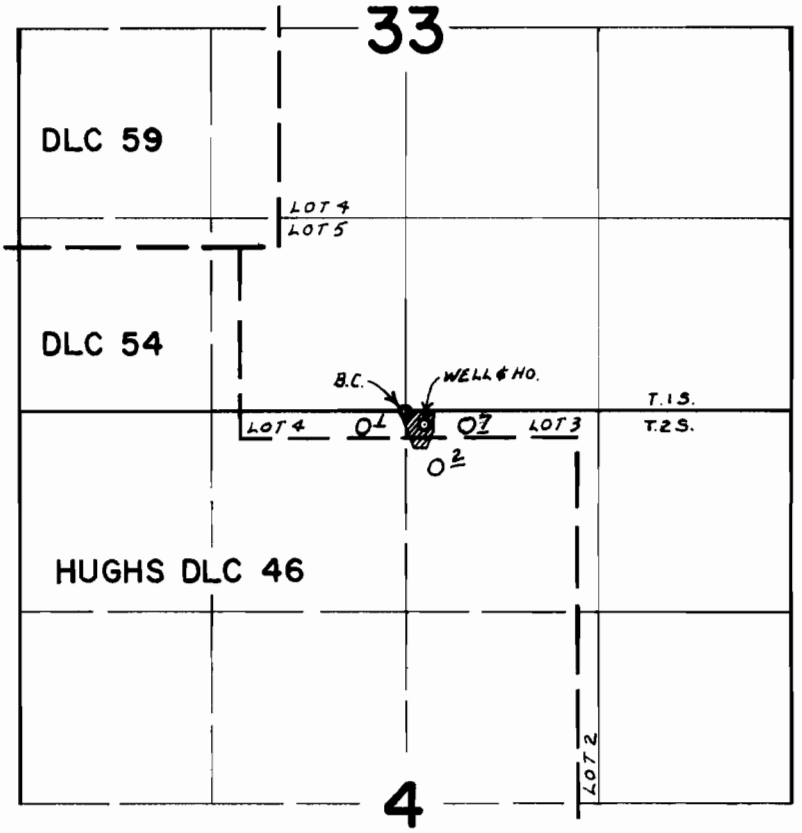

WELL LOC. 90'S. & 135'E. FROM N. 1/4 COR. SEC 4

FINAL PROOF SURVEY

Application No. G-2551 Permit No. G-2364

IN NAME OF

EDWARD H. KIRSCHBAUM, Jr.

Surveyed NOV. 16 70 by G. BACA

1970-F