


T.3S.R.2E.W.M.

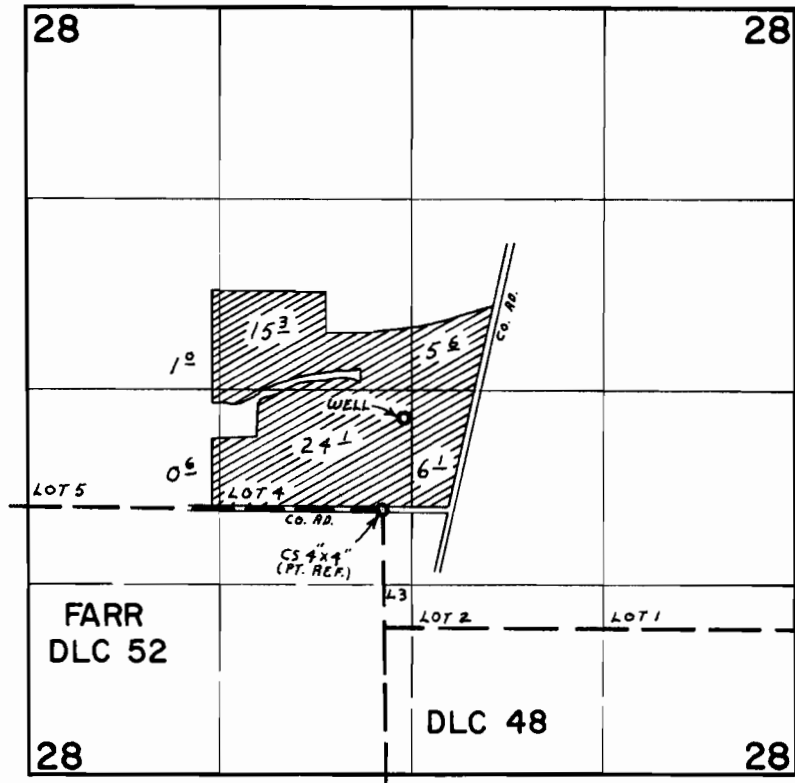

WELL LOC. 670' N. & 150' E. FROM NE COR. FARR DLC 52

DONALD E. BLOOM

G-2631 G-2454

ELDON EVANS

SEPT. 3, 1970 G. BACA