

File copy.


RECEIVED

AUG 11 1971

STATE ENGINEER
SALEM OREGON

T.3S.R.1E.W.M.

Application No. G-5596
Permit No. G-4908

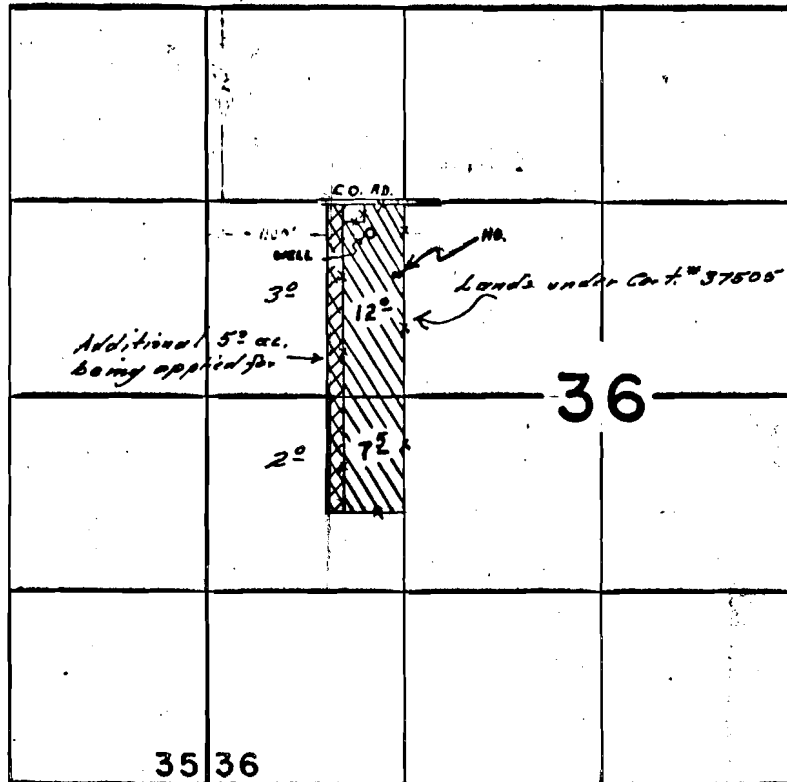

WELL LOC. 210'S. & 230'W. FROM NE COR. SW 1/4 NW 1/4 SEC. 36


FINAL PROOF SURVEY
UNDER

Application No. G-2958 Permit No. G-2752
IN NAME OF

GIRTHIE E. MASSEY

Surveyed SEPT. 8, 1970, by G. BACA

T.3S.R.1E.W.M.

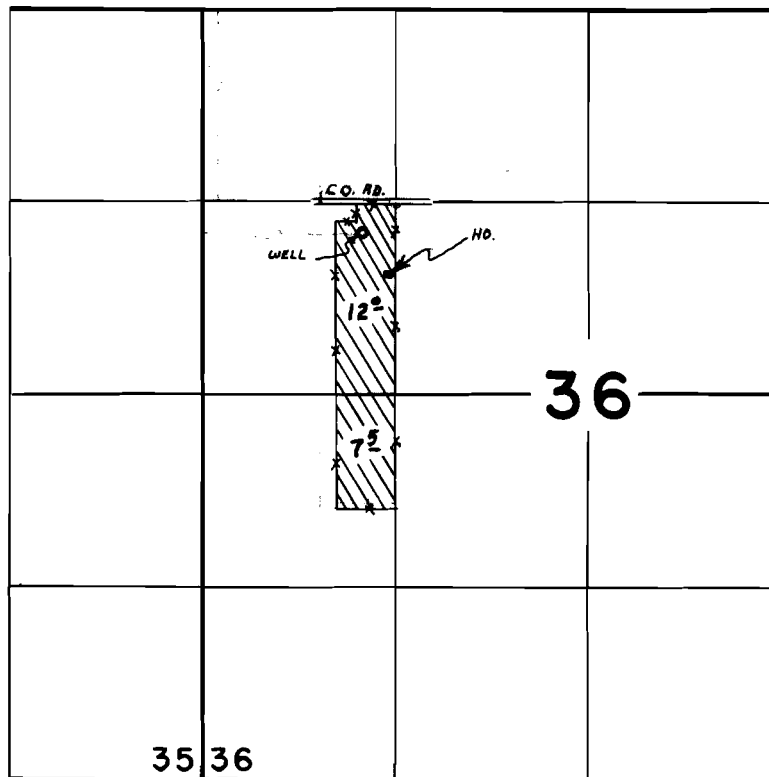

WELL LOC. 210' S. & 230' W. FROM NE COR. SW $\frac{1}{4}$ NW $\frac{1}{4}$ SEC. 36

FINAL PROOF SURVEY
UNDER

Application No. G-2958 Permit No. G-2752
IN NAME OF

GIRTHIE E. MASSEY

Surveyed SEPT. 8, 1970, by G. BACA