


T.4 S.R. I.E.W.M.

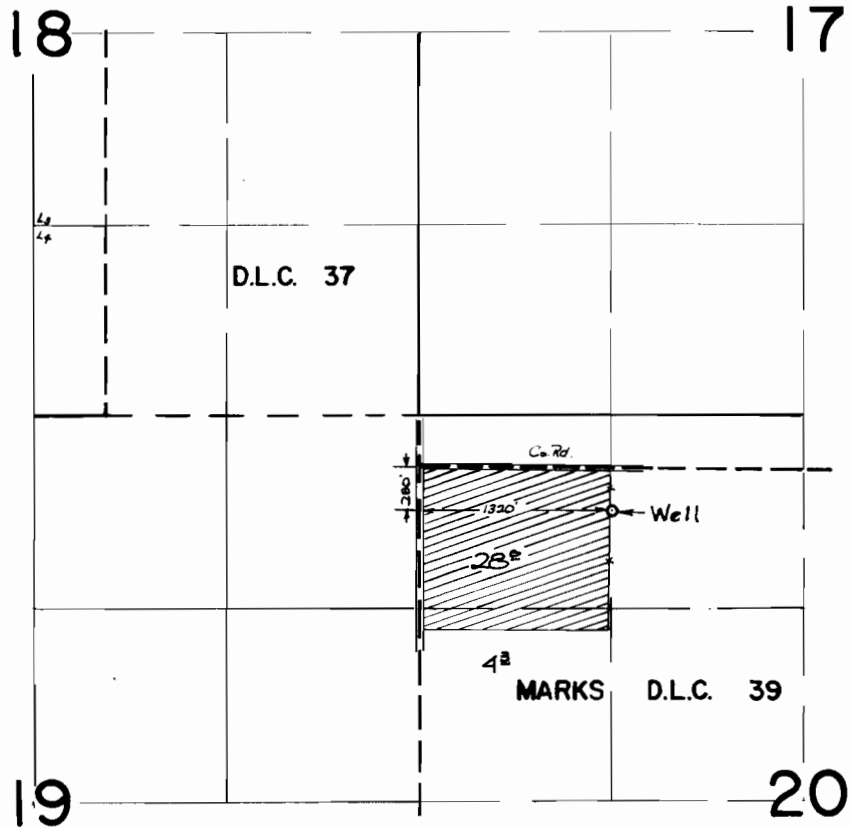

FINAL PROOF SURVEY
UNDER

Application No. G 3573 Permit No. G 3101
IN NAME OF

ROBERT MAY

Surveyed 19 AUG. 1970, by D. R. BUELL