


T. 4 S. R. 1 E. W. M.

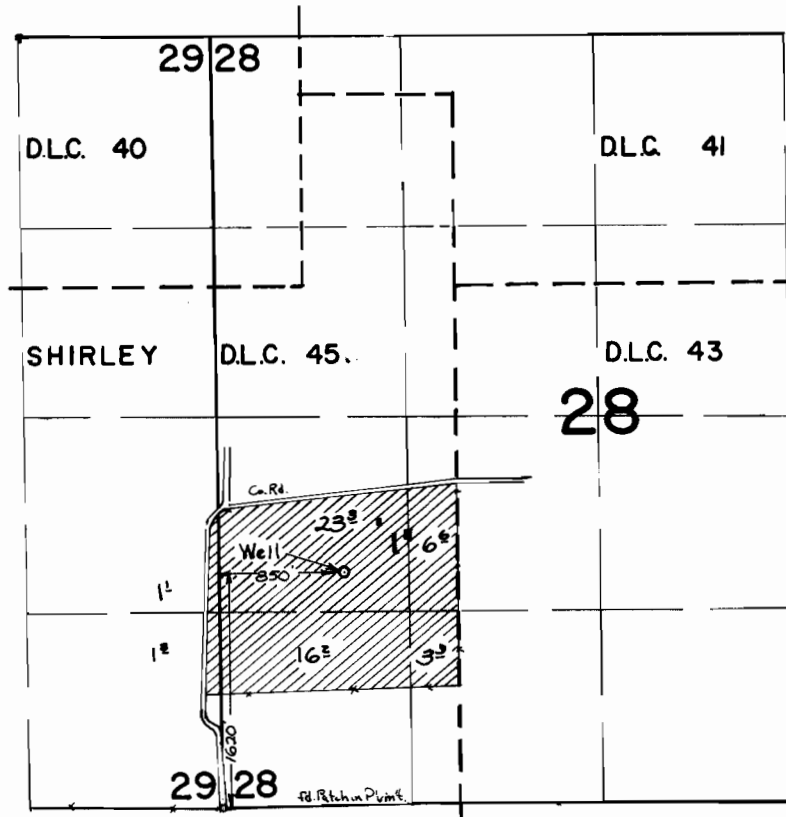

FINAL PROOF SURVEY UNDER

Application No. G 3391 Permit No. G 3185
IN NAME OF

HOMER KNOPP

Surveyed 19 AUG 1970, by D. R. BUENL