


T.2S.R.2&3E.W.M.

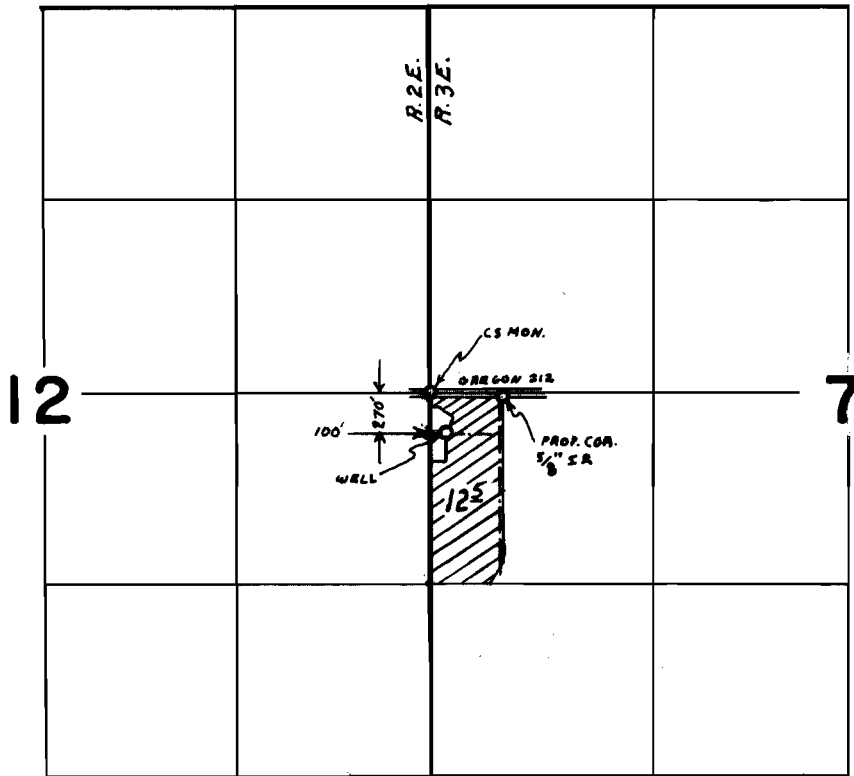

FINAL PROOF SURVEY
UNDER

Application No. G-3666 Permit No. G-3442
IN NAME OF

FREDERICK L. SIRI

Surveyed SEPT. 30 1970, by G. BACA