


T.3S.R.1E.W.M.

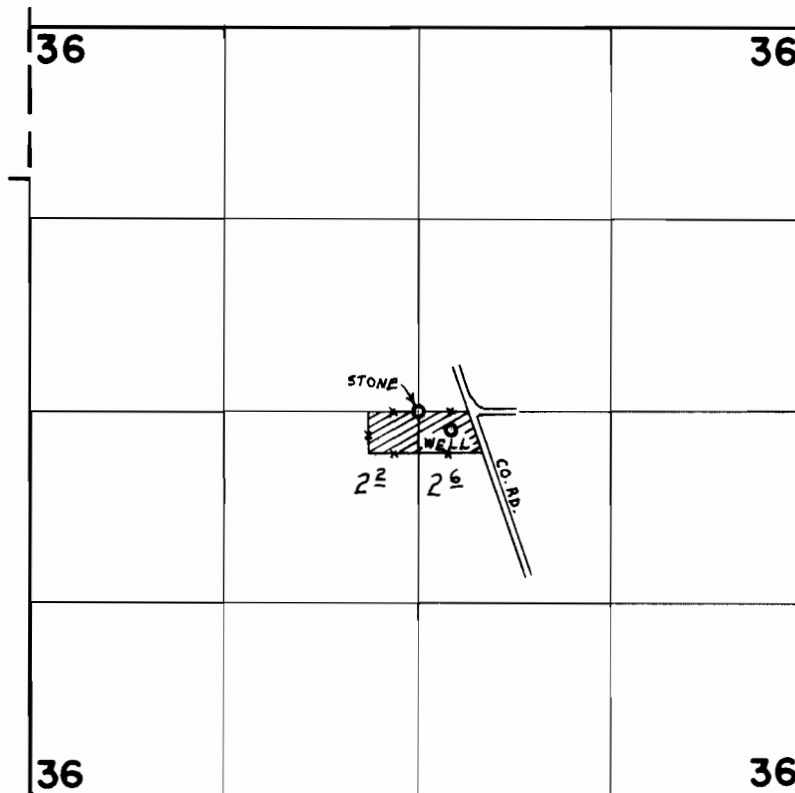

WELL LOC. 130'S. & 230'E. FROM CENTER SEC. 36

FINAL PROOF SURVEY
UNDER

Application No. G-3703 Permit No. G-3766
IN NAME OF

HOMER DALE MEYERS

Surveyed NOV. 18 1970, by L. E. GOUARD