


T.2S.R.4E.W.M.

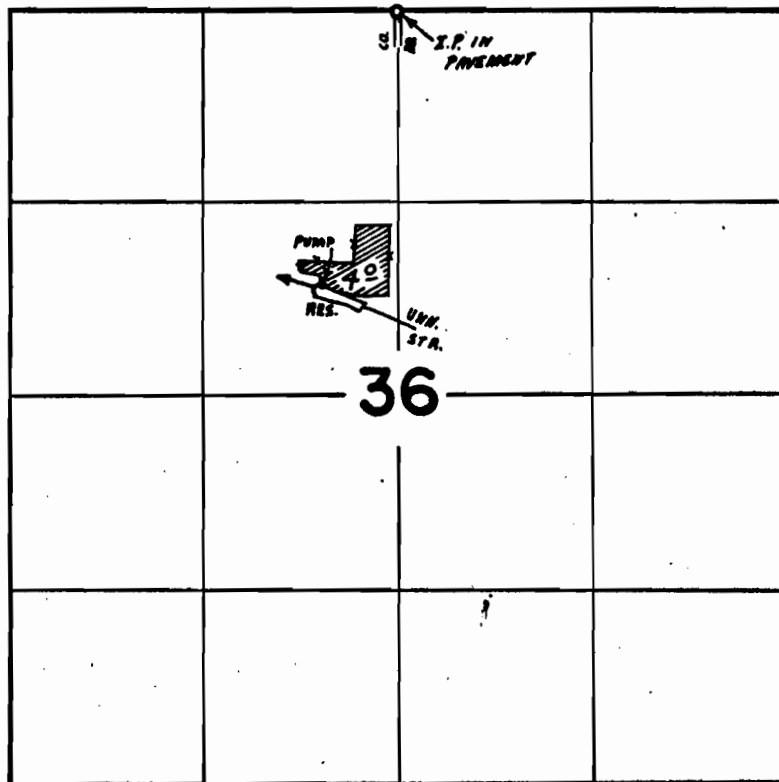

DIV. PT. LOC. 1920'S. & 570' W. FROM N¹/₄ COR. SEC. 36

FINAL PROOF SURVEY

UNDER

R-34854

A-2686

Application No. 34855 Permit No. 27633

IN NAME OF

WILLIAM S. LAWSON

Surveyed NOV. 12 1970, by G. BACA