


T.3S.R.2E.W.M.

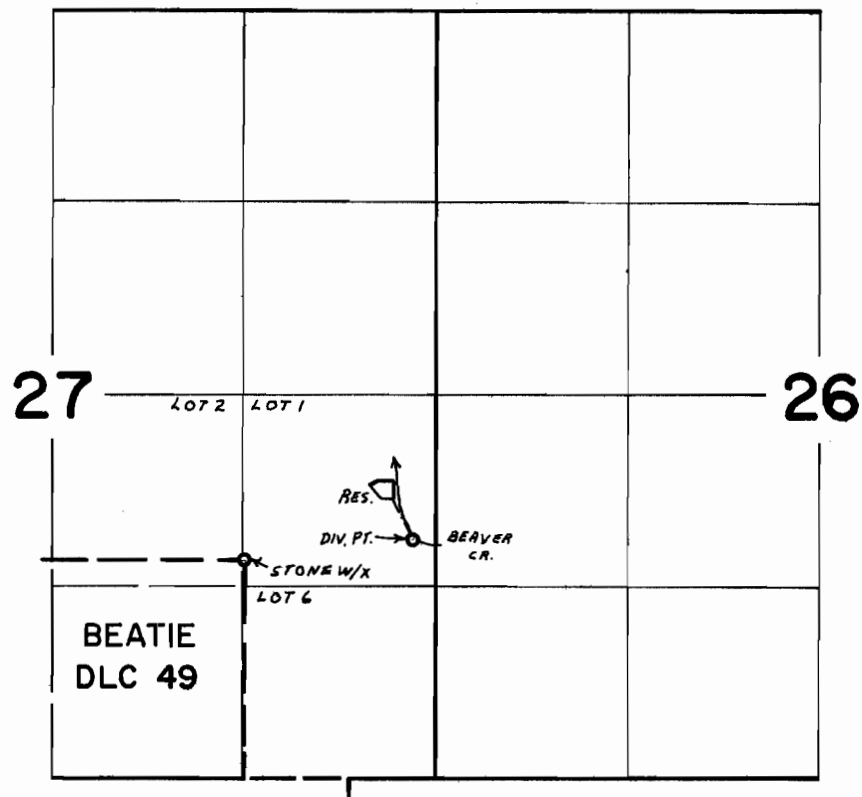

DIV. PT. LOC. 170' N. & 1150' E. FROM NE COR. BEATIE DLC 49

FINAL PROOF SURVEY

UNDER

R-39990

R-4132

Application No. 3999/ Permit No. 29789

IN NAME OF

CLARENCE OAK

Surveyed SEPT. 3, 1970, by G. BACA