


T.1S.R.4E.W.M.

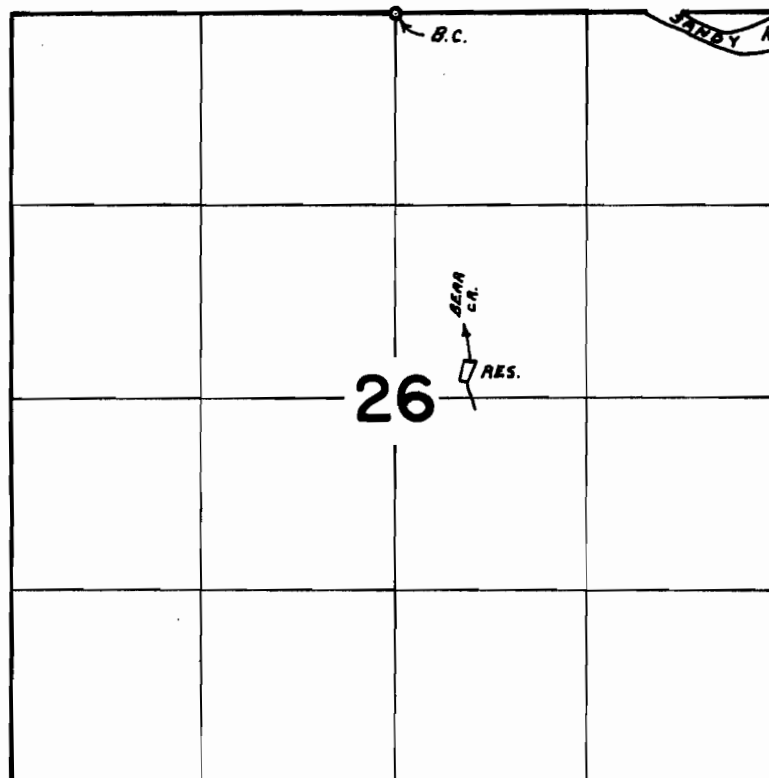

DIV. PT. LOC. 2390' S. & 500' E. FROM N $\frac{1}{4}$ COR. SEC. 26

FINAL PROOF SURVEY

UNDER

~~R-10188~~

~~R-1178~~

Application No. ~~10189~~ Permit No. ~~29953~~

IN NAME OF

MARVIN F. BEHRENS

Surveyed **NOV. 4** 19 **70**, by **G. BALCA**