


T.I.S.R.4E.W.M.

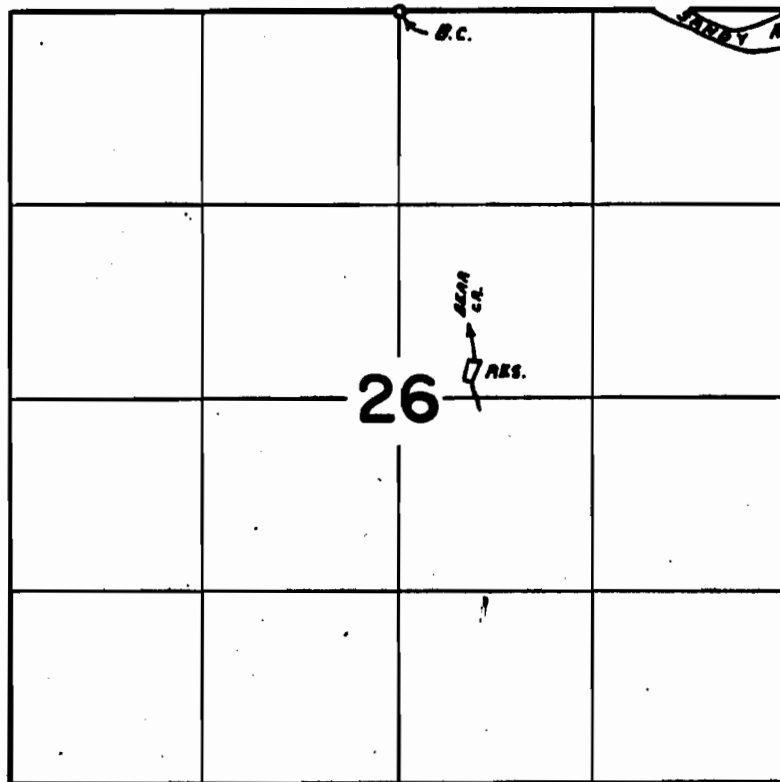

DIV. PT. LOC. 2390'S. & 500'E. FROM N $\frac{1}{4}$ COR. SEC. 26

FINAL PROOF SURVEY

UNDER

Application No. R-10/88 Permit No. R-1478
10/89 29953

IN NAME OF

MARVIN F. BEHRENS

Surveyed NOV. 1 19 70, by G. BACA