


T.2S.R.4E.W.M.

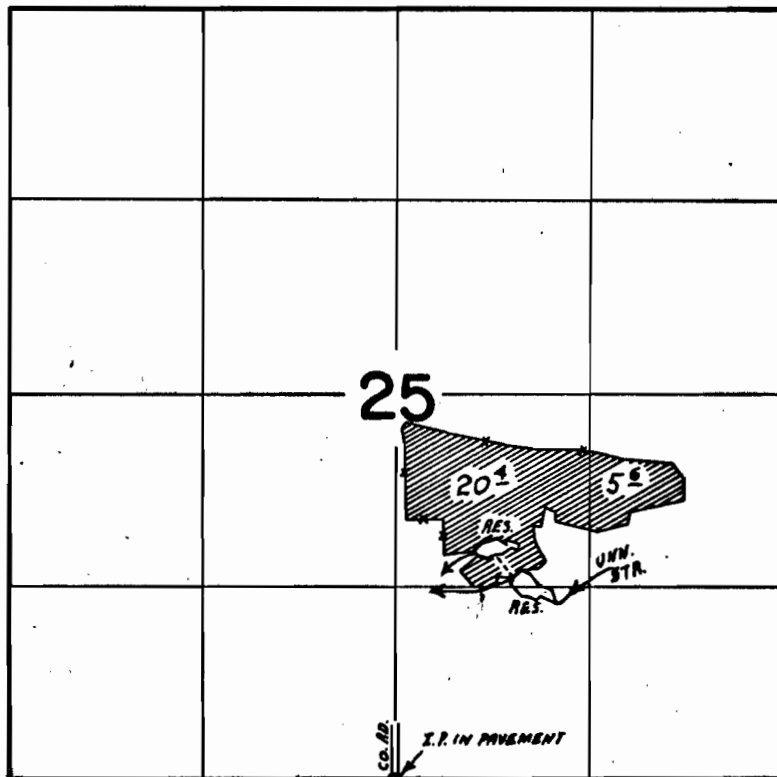

DIV. PT. LOC. 1350' N. & 790' E. FROM S $\frac{1}{4}$ COR. SEC. 25 (ALSO S. RES. DIV. PT.); N. RES. DIV. PT. LOC. 1540' N. & 510' E. FROM S $\frac{1}{4}$ COR. SEC. 25

FINAL PROOF SURVEY

UNDER

Application No. 38985 Permit No. 29014
40950 R-10912 R-4588
30509

IN NAME OF

DALE C. QUINN

Surveyed NOV. 13 19 70, by G. BACA