


T.2S.R.4E.W.M.

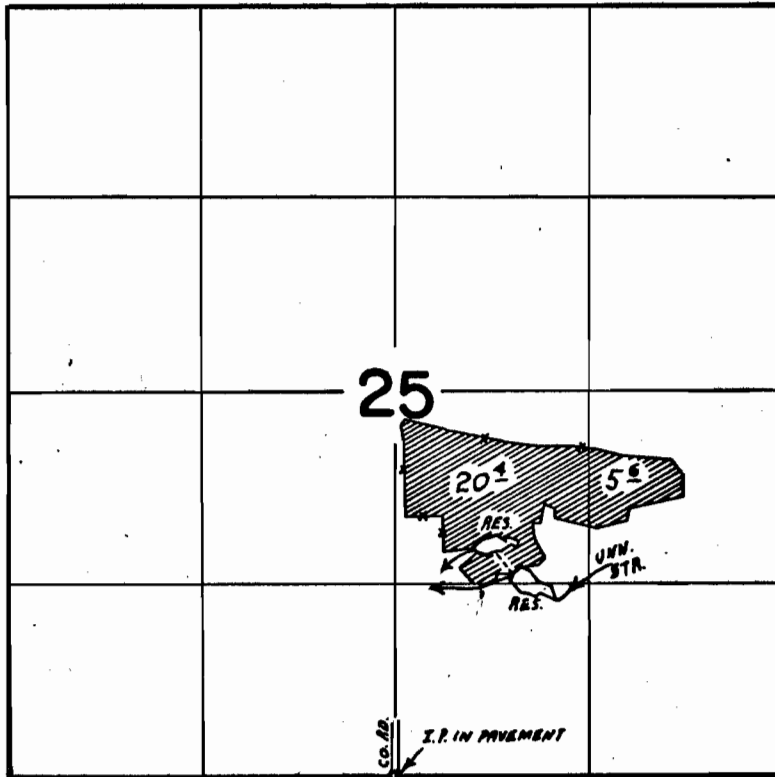

DIV. PT. LOC. 1350' N. & 790' E. FROM S $\frac{1}{4}$ COR. SEC. 25 (ALSO S. RES. DIV. PT.); N. RES. DIV. PT. LOC. 1540' N. & 590' E. FROM S $\frac{1}{4}$ COR. SEC. 25

FINAL PROOF SURVEY

UNDER

38985

29044

Application No. ~~R-10949~~ Permit No. ~~R-1588~~

10950

30509

IN NAME OF

DALE C. QUINN

Surveyed NOV. 13 19.70., by G. BACA