


T.3S.R.1E.W.M.

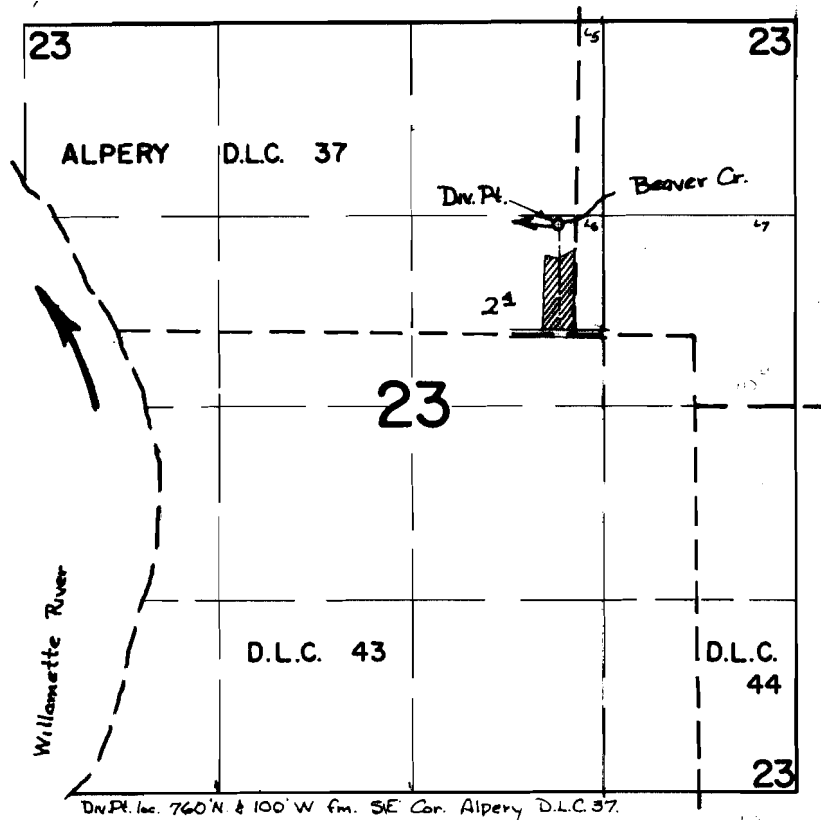

FINAL PROOF SURVEY UNDER

Application No. 41956..... Permit No. 31041
IN NAME OF

ARDEN L. POTTRATZ & LOUISE C. POTTRATZ

Surveyed 21 AUG..... 1970., by D.R. BUELL.....