T.3S.R.1E.W.M.

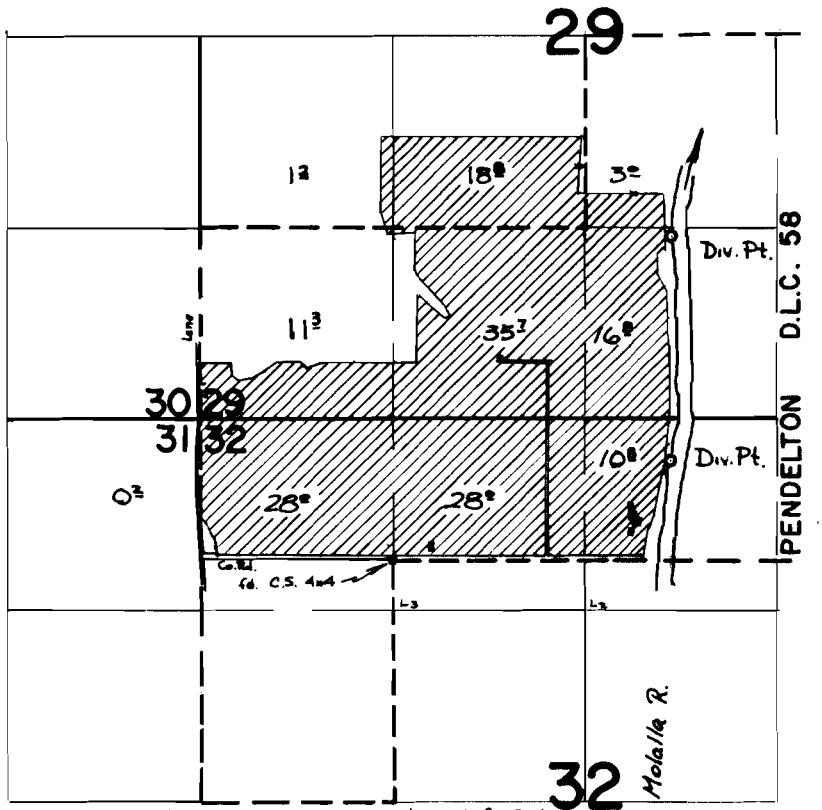

Div. Pts. loc.: 2240'N. & 1910'E.; 680'N. & 1900'E. both from South Int. "L" Cor. D.L.C. 58.

FINAL PROOF SURVEY
UNDER

Application No. 44161 Permit No. 32741
IN NAME OF

JOHN & REUBEN FAWVER

Surveyed 20 AUG 1970, by D.R.BUELL

1970-D B.F.S.