


T. 3S. R. 1E. W. M.

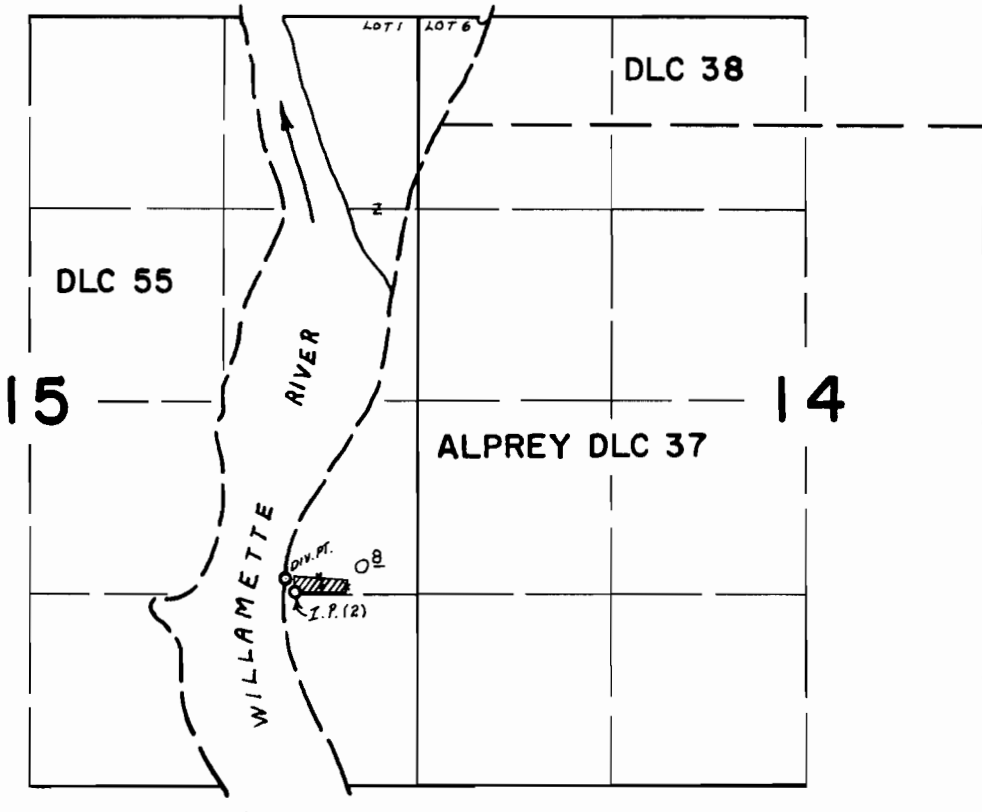

DIV. PT. LOC. 3100'S. & 4770' W. FROM NE COR. ALPREY DLC 37

FINAL PROOF SURVEY UNDER

Application No. 45323 Permit No. 33282
IN NAME OF

TIMOTHY R. AUXIER & LINDA M. AUXIER

Surveyed SEPT. 8 1970, by G. BACA