


T.2S.R.3E.W.M.

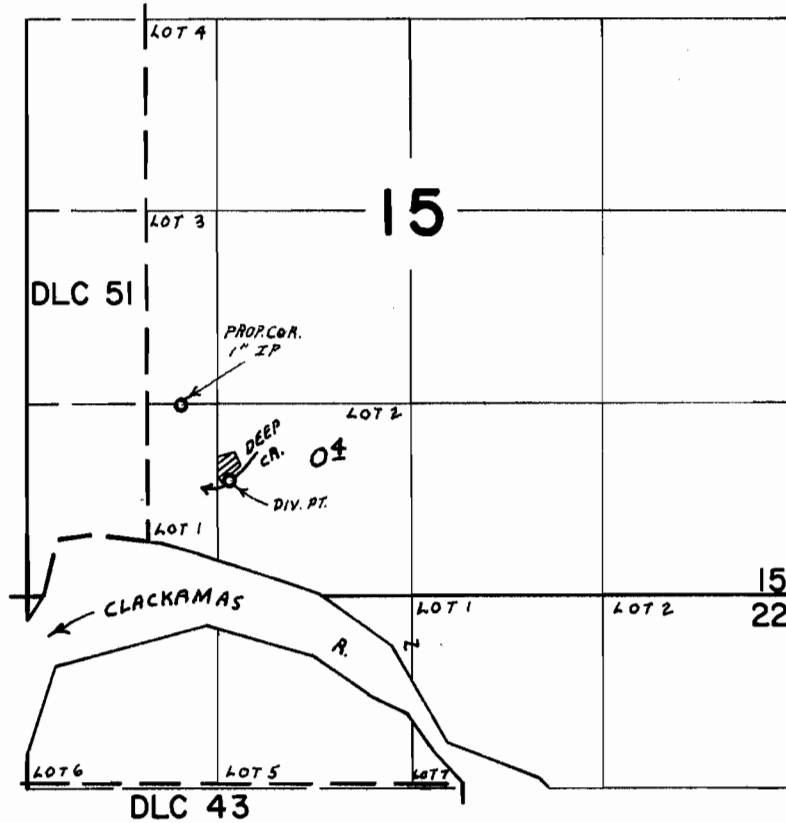

DIV. PT. LOC. 1850'S. & 1250'W. FROM CENTER SEC. 15

FINAL PROOF SURVEY

UNDER

Application No. 44708 Permit No. 33473

IN NAME OF

EARL J. WILLIAMSON

Surveyed NOV. 10 19 70, by G. BACA