


# T. 31S. R. 12W. W.M.

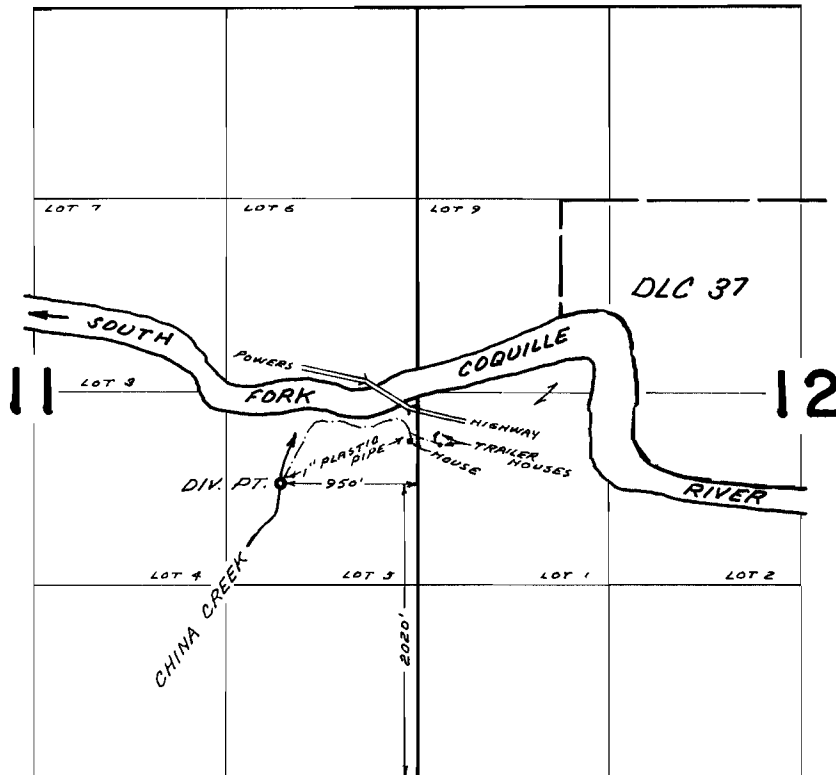

## FINAL PROOF SURVEY UNDER

Application No. 33620 Permit No. 26614  
IN NAME OF

IRL T. DEADMOND

Surveyed AUG 19 1969, by D. BUELL