


T. 28 & 29 S. R. 12 W. W.M.

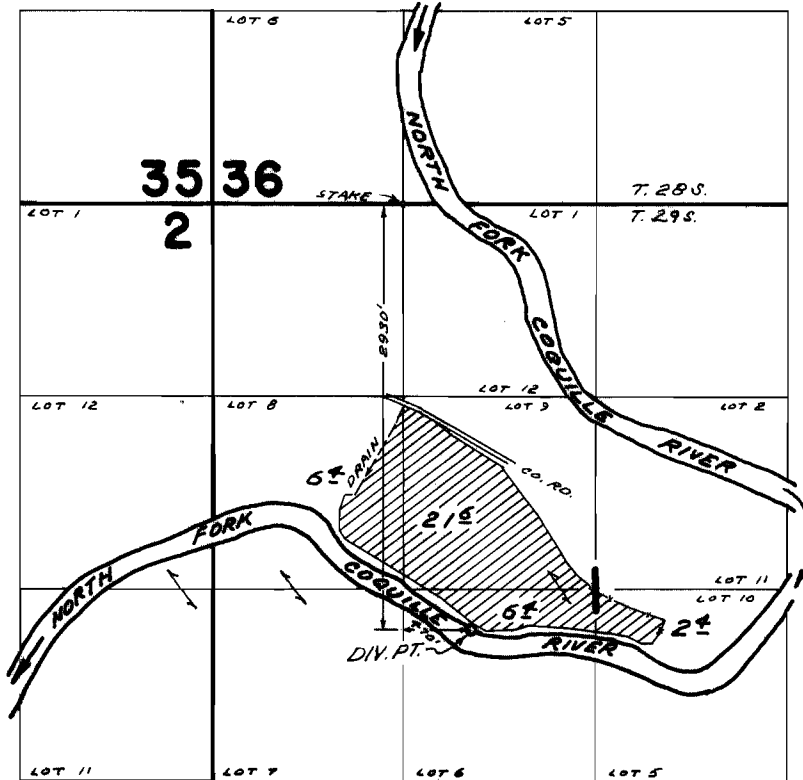

FINAL PROOF SURVEY
UNDER

Application No. 39513 Permit No. 29323
IN NAME OF

PERCY D. BARZEE

Surveyed SEP 12 1969, by D. BUELL