


T.31S.R.12W.W.M.

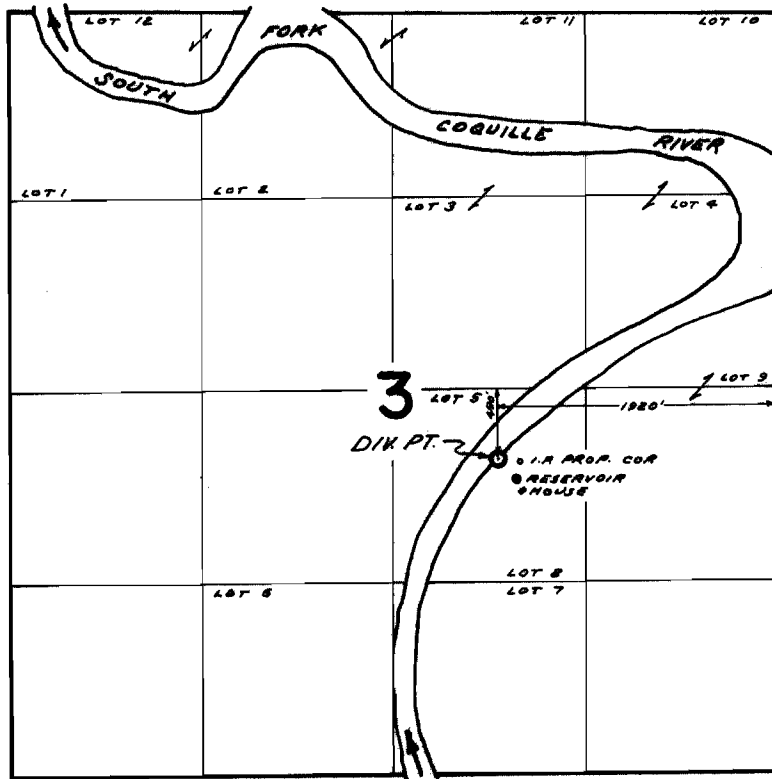

FINAL PROOF SURVEY
UNDER

Application No. 39650 Permit No. 29460
IN NAME OF

HAROLD J. BLONDELL

Surveyed AUG. 19 1969, by D. BUELL